REC $ 5.00
AUD $
H.M.F. $ 1.00
5.00

COMPUTER ✓
RECORDED ✓
COMPARED

FILED NO. 7197
BOOK 2003 PAGE 7197
2003 DEC -5 AM 10:45
MICKI UTSLER
RECORDER
MADISON COUNTY, IOWA

VANCE & HOCHSTETLER, P.C., CONSULTING ENGINEERS, WINTERSET, IOWA (515) 462-3995
03-1855 CHARLES T. VANCE, 110 West Green St., Winterset, Iowa, 50273
Kopaska JAMES M HOCHSTETLER, 110 West Green St., Winterset, Iowa 50273

UNITED STATES PUBLIC LAND SURVEY CORNER CERTIFICATE
OF


Land Survey Monuments situated in Section 6, Township 76N, Range 29W, of the Fifth Principal Meridian, MADISON County, Iowa.
Previously recorded in _____ in County Recorder's Office.
(book, page, document number, etc.)


(Show reason for preparing this certificate, the evidence and detailed procedures used in establishing the the corner positions and monumentation found or placed.)


Monument Description and Remarks: SW Cor SE¼SE¼ - Set yellow CIR #6808 4" Deep at midpoint on line between found S¼ Cor and SE. cor. NE COR SE¼SE¼ - Set yellow CIR #6808 4" Deep - Calculated E¼ Corner by projecting found W¼ Corner Through old existing property line fence Corner at center of Section then set corner at midpoint on line between Calculated E¼ Cor. & found S.E. cor. NW Cor. SE¼ SE¼ - Set CIR #6808 at Calculated intersect of lines from midpoint of Sides of the Southeast Quarter.

PLAN - VIEW

(Show a minimum of three reference ties to durable physical objects, relevant monuments and physical conditions that will enable recovery of the corner.)

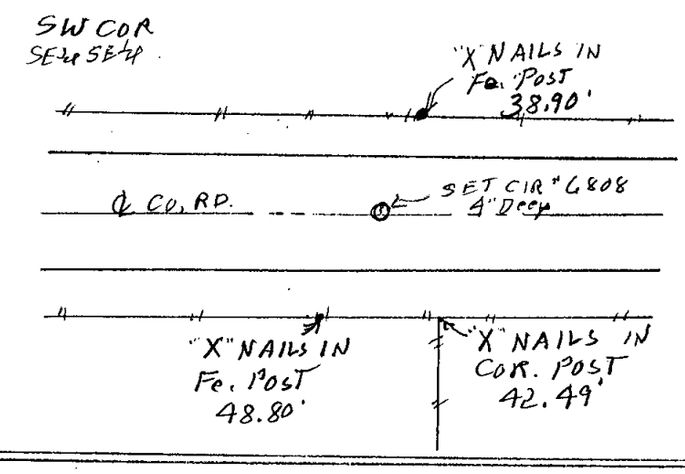

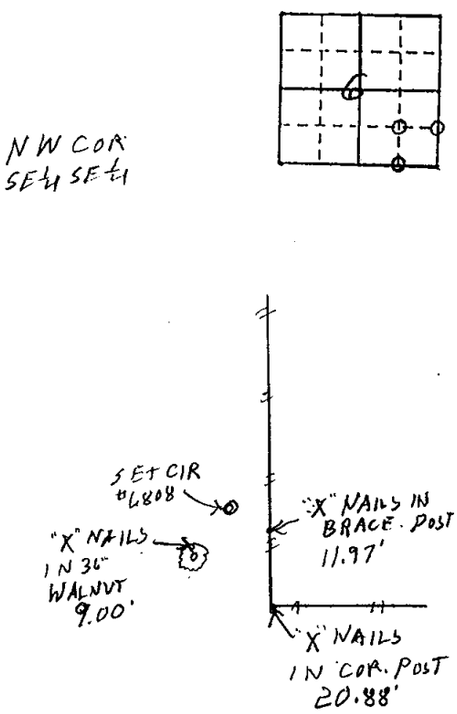

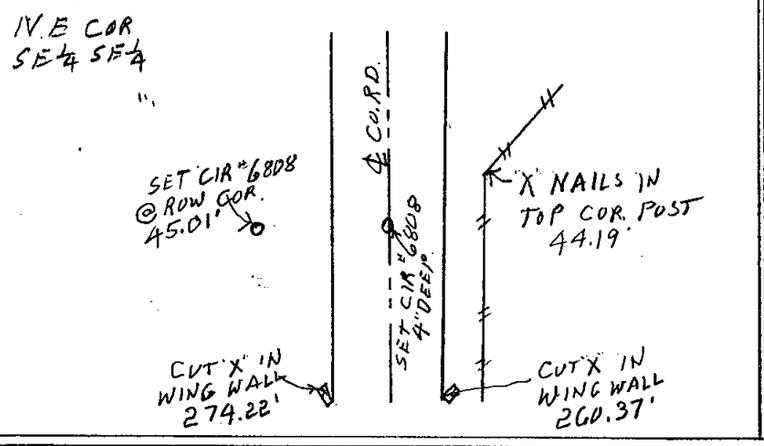

LICENSED LAND SURVEYOR
J. M. HOCHSTETLER
6808
IOWA

I hereby certify that this land surveying document was prepared and the related survey work was performed by me or under my direct personal supervision and that I am a duly licensed Land Surveyor under the laws of the State of Iowa.

J.M. HOCHSTETLER
License number 6808 Date 12/1/03.
My license renewal date is December 31, 2003
Pages or sheets covered by this seal: 1

List Corners to be Indexed

Corners	Section	Twp	Range
SW COR SE¼ SE¼	6	76N	29W
NE COR SE¼ SE¼	6	76N	29W
NW COR SE¼ SE¼	6	76N	29W