

REC \$ 5⁰⁰
 AUD \$
 R.M.F. \$ 1⁰⁰
 5⁰⁰

FILED NO. **7198**
 BOOK **2003** PAGE **7198**
 2003 DEC -5 AM 10:46



COMPUTER
 RECORDED
 COMPARED

MICKI UTSLER
 RECORDER
 MADISON COUNTY, IOWA


VANCE & HOCHSTETLER, P.C. CONSULTING ENGINEERS, WINTERSET, IOWA (515) 462-3995
 CHARLES T. VANCE, 110 WEST GREEN ST., WINTERSET, IOWA 50273
 JAMES M HOCHSTETLER, 110 WEST GREEN ST., WINTERSET, IOWA 50273

PLAT OF SURVEY OF LOTS 5, 6 AND THE WEST 6 FEET OF LOT 7
 OF THE RE-SUBDIVISION OF BLOCK 21 OF PITZER & KNIGHT'S ADDITION
 TO THE TOWN OF WINTERSET, MADISON COUNTY, IOWA OWNED BY
 RANDALL AND CATHY SIMON.

NW.COR.
 SW.1/4 NW.1/4
 SEC. 31-76-27
 FD.IA.DOT DISC.

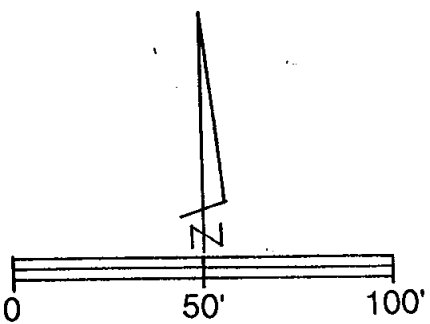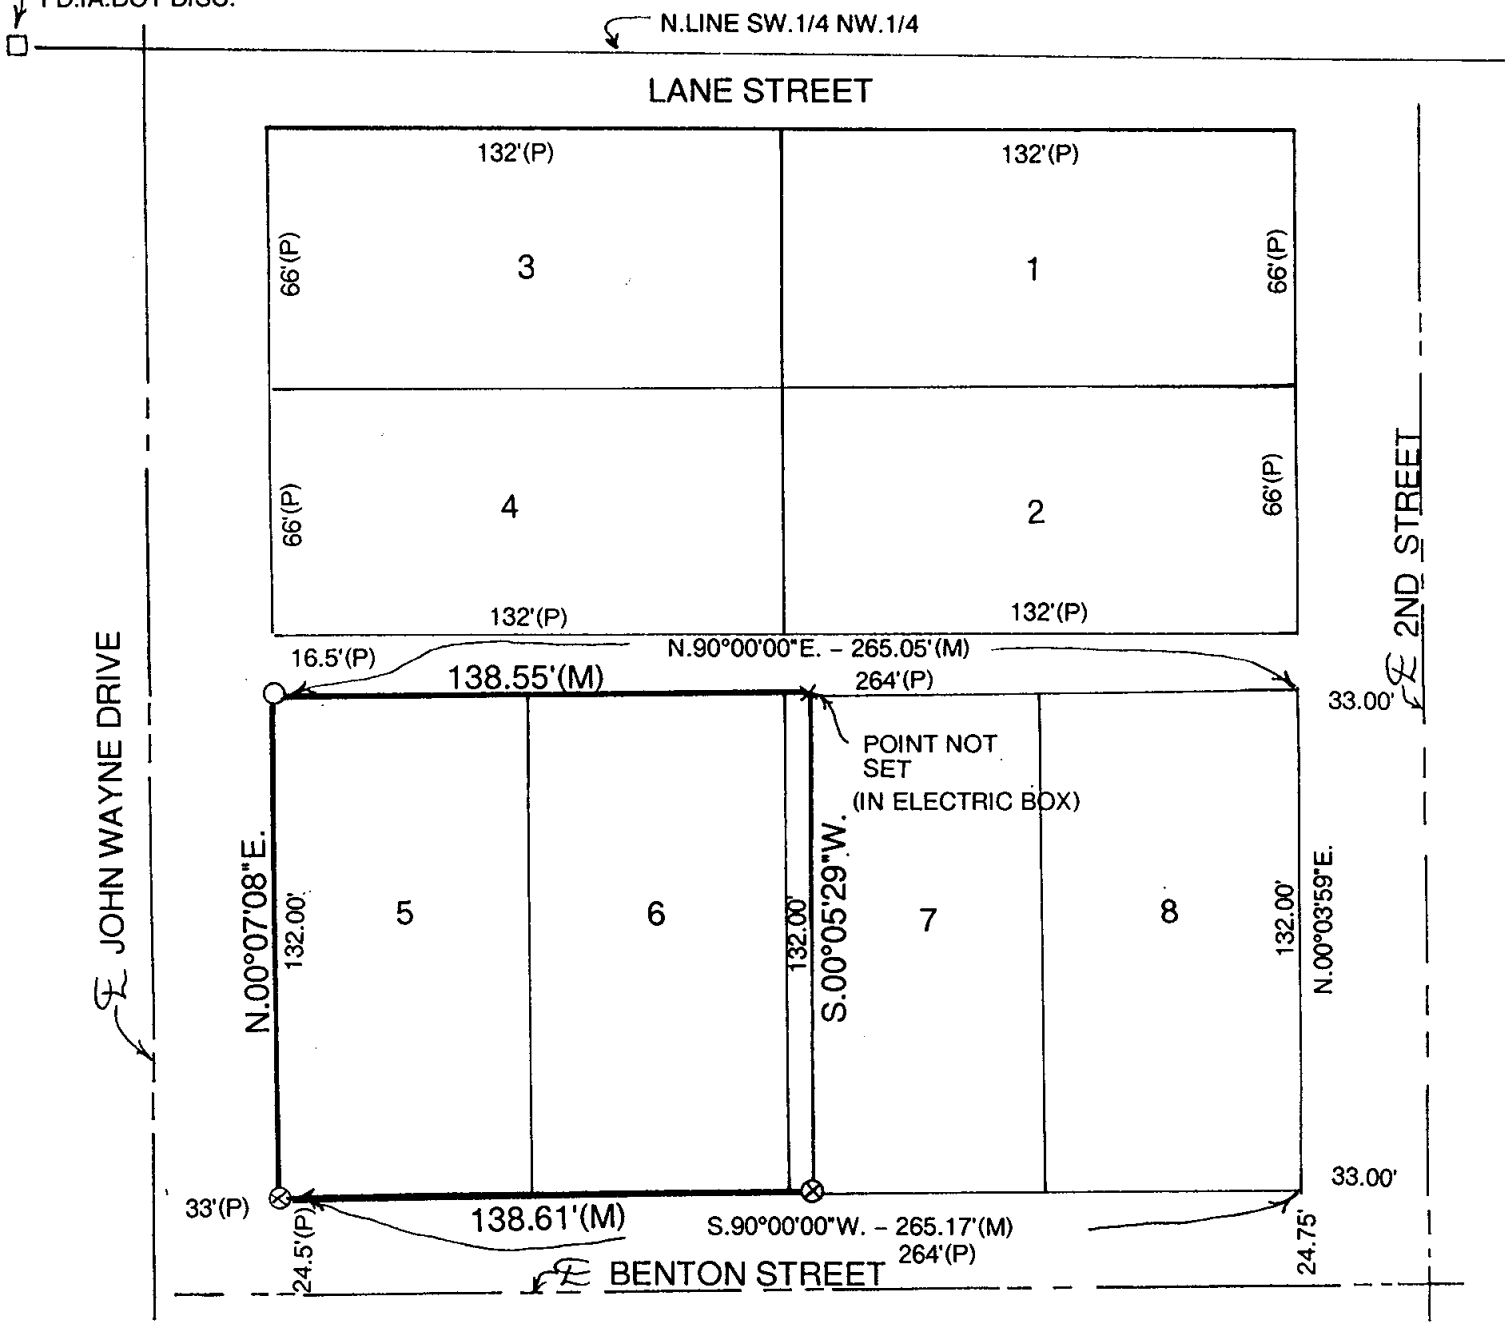

○ CAPPED IRON ROD (CIR)# 6808 SET
 ⊗ CUT IN CONCRETE
 □ IA. DOT DISC. FOUND

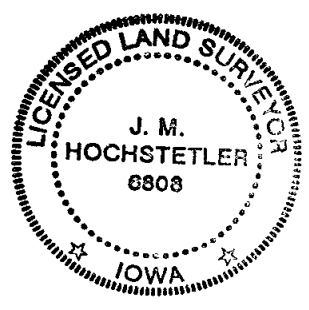

I hereby certify that this land surveying document was prepared and the related survey work was performed by me or under my direct personal supervision and that I am a duly licensed Land Surveyor under the laws of the State of Iowa.

J.M. Hochstetler
 J.M. HOCHSTETLER
 License number 6803 Date 11/25/03
 My license renewal date is December 31, 2003
 Pages or sheets covered by this seal: 1