REC $ 5.00
AUD $
R.M.F. $ 1.00
5.00

COMPUTER ✓
RECORDED ✓
COMPARED

FILED NO: 7191
BOOK 2003 PAGE 7191
2003 DEC -5 AM 10: 39
MICKI UTSLER
RECORDER
MADISON COUNTY, IOWA

VANCE & HOCHSTETLER, P.C., CONSULTING ENGINEERS, WINTERSET, IOWA (515) 462-3995
03-1685 CHARLES T. VANCE, 110 West Green St., Winterset, Iowa, 50273
JAMES M HOCHSTETLER, 110 West Green St., Winterset, Iowa 50273


UNITED STATES PUBLIC LAND SURVEY CORNER CERTIFICATE OF

Land Survey Monuments situated in Section 25, Township 75 N, Range 28 W, of the Fifth Principal Meridian, MADISON County, Iowa.
Previously recorded in _____ in County Recorder's Office.
(book, page, document number, etc.)

(Show reason for preparing this certificate, the evidence and detailed procedures used in establishing the the corner positions and monumentation found or placed.)

Monument Description and Remarks: NE Cor SE¼SE¼ - Set yellow CIR #6808 on line at midpoint between found SE Cor & E¼ Cor.
SW Cor SE¼SE¼ - Set yellow CIR #6808 at mid point between found SE Cor and S¼ Cor established by split of Road ROW in line with properly line fences E. & W.
NW Cor SE¼SE¼ - Set yellow CIR #6808 on line between found nail at NW Cor NE¼SE¼ and Set Cor at SW Cor SE¼SE¼ at intersect with line from Set NE Cor SE¼SE¼ to mid point of line from S¼ Cor to found Center of Sec. PLAN - VIEW

(Show a minimum of three reference ties to durable physical objects, relevant monuments and physical conditions that will enable recovery of the corner.)

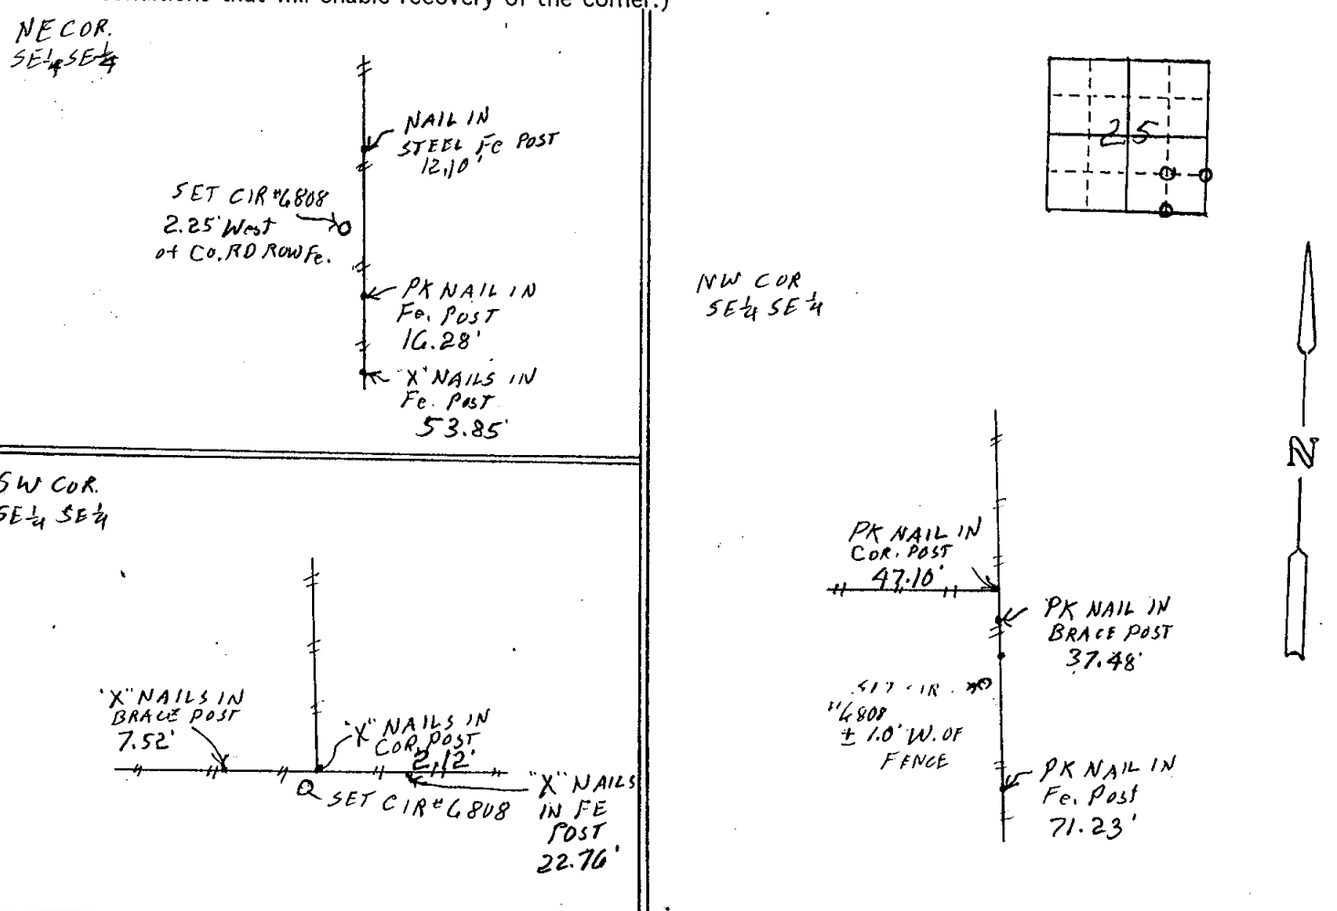



I hereby certify that this land surveying document was prepared and the related survey work was performed by me or under my direct personal supervision and that I am a duly licensed Land Surveyor under the laws of the State of Iowa.

J.M. HOCHSTETLER
License number 6808 Date 11/12/03
My license renewal date is December 31, 2003
Pages or sheets covered by this seal: 1

List Corners to be Indexed

Corners	Section	Twp	Range
NE COR SE¼SE¼	25	75N	28W
SW COR SE¼SE¼	25	75N	28W
NW COR SE¼SE¼	25	75N	28W