REC $ 5.00
AUD $
R.M.F. $ 1.00
5.00

COMPUTER ✓
RECORDED ✓
COMPARED

FILED NO: 7333
BOOK 2003 PAGE 7333
2003 DEC 16 AM 11:16
MICKI UTSLER
RECORDER
MADISON COUNTY, IOWA

RETURN TO : BOLDMAN LAND SURVEYING, P.C., BOX 66, WINTERSET, IA 50273 515-462-9242

UNITED STATES PUBLIC LAND SURVEY CORNER CERTIFICATE OF


Land Survey Monuments situated in Section 28, Township 75, Range 28, of the Fifth Principal Meridian, Madison County, Iowa
Previously recorded in None found In County Recorder's Office.
(book, page, document number, etc.)

(show reason for preparing this certificate, the evidence and detailed procedures used in establishing the corner positions and monumentation found or placed.)


Monument Description and Remarks: N/4 Corner - found stone logged by County Engineer's office. NW Corner - found 1" Alum. Cap monument in ℄ intersection. SW Cor NW¼ NW¼ - found hex bolt in ℄ in line w fences. SE Cor. NE¼ NW¼ - Set ½"x 24" reb. org. cap at fence cor.

PLAN-VIEW


(Show a minimum of three reference ties to durable physical objects, relevant monuments and physical conditions that will enable recovery of the corner.)

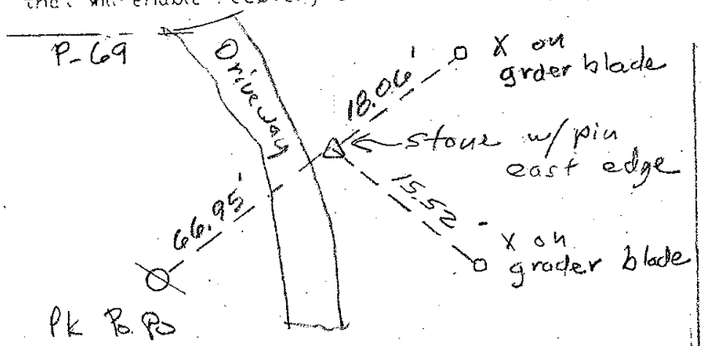


N¼ Cor.

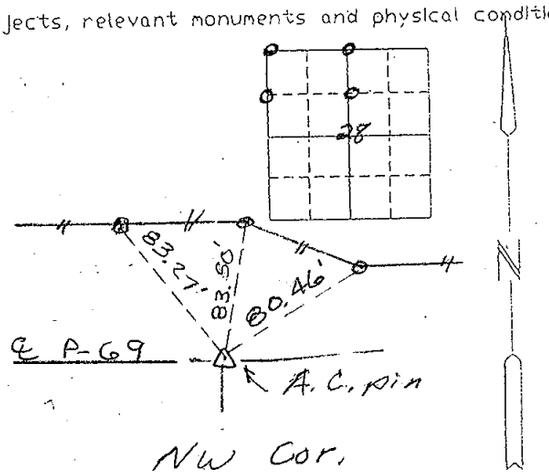

NW Cor.

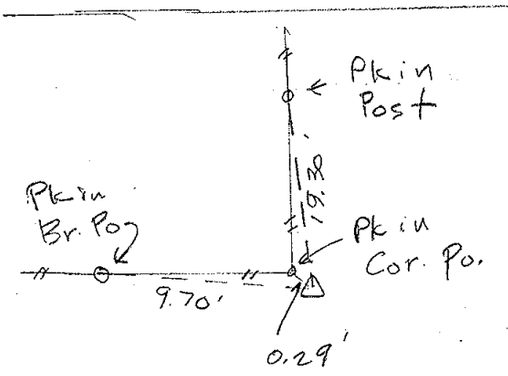

SE cor. NE¼ NW¼

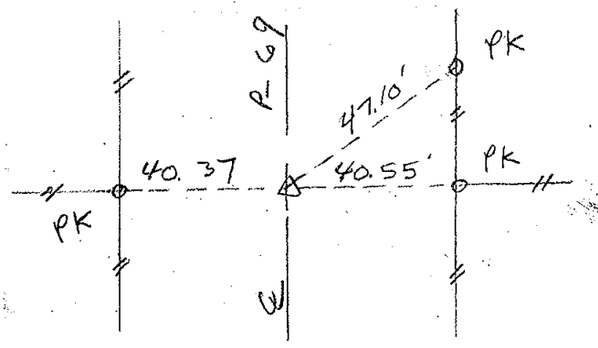

SW Cor. NW¼ NW¼

I hereby certify that the survey work was completed and this certificate was prepared by me or under my direct personal supervision and that I am a duly Licensed Land Surveyor under the laws of the State of Iowa

Signature: Craig S. Boldman
Craig S. Boldman

Date: 12/12/03 Reg. No. 13427

SEAL

LICENSED LAND SURVEYOR
CRAIG S. BOLDMAN
13427
IOWA

List Corners to be Indexed

Corners	Section	Twp	Range
N¼	28	75	28
SE Cor NE¼ NW¼	"	"	"
NW	"	"	"
SW Cor. NW¼ NW¼	"	"	"