REC $ 5 00
AUD $
R.M.F. $ 1 00
5 00

FILED NO. 7543
BOOK 2003 PAGE 7543
2003 DEC 30 PM 2:27

COMPUTER ✓
RECORDED ✓
COMPARED

NICKI UTSLER
RECORDER
MADISON COUNTY, IOWA

VANCE & HOCHSTETLER, P.C., CONSULTING ENGINEERS, WINTERSET, IOWA (515) 462-3995
CHARLES T. VANCE, 110 West Green St., Winterset, Iowa, 50273
JAMES M HOCHSTETLER, 110 West Green St., Winterset, Iowa 50273

03-223S
Smith

UNITED STATES PUBLIC LAND SURVEY CORNER CERTIFICATE
OF


Land Survey Monuments situated in Section 11, Township 76 N, Range 29 W, of the Fifth Principal Meridian, MADISON County, Iowa.
Previously recorded in _____ (book, page, document number, etc.) in County Recorder's Office.

(Show reason for preparing this certificate, the evidence and detailed procedures used in establishing the the corner positions and monumentation found or placed.)

Monument Description and Remarks: NE Cor SE¼ NW¼ - Set yellow CIR #6808 exposed on line between found N¼ Cor. and set Center of Section and parallel to a line from found SW Cor. SE¼ NW¼ to Set Center of Section, Center of Section - Set yellow CIR #6808 at intersection of line from found N¼ Corner to Calculated S¼ Corner with line from found SW Cor. SE¼ NW¼ to old property line fence Corner at E¼ Corner. NW Cor SE¼ NW¼ - Set yellow CIR #6808 at mid point on line between found SW Cor SE¼ NW¼ and NW Cor. NE¼ NW¼.

PLAN - VIEW

(Show a minimum of three reference ties to durable physical objects, relevant monuments and physical conditions that will enable recovery of the corner.)

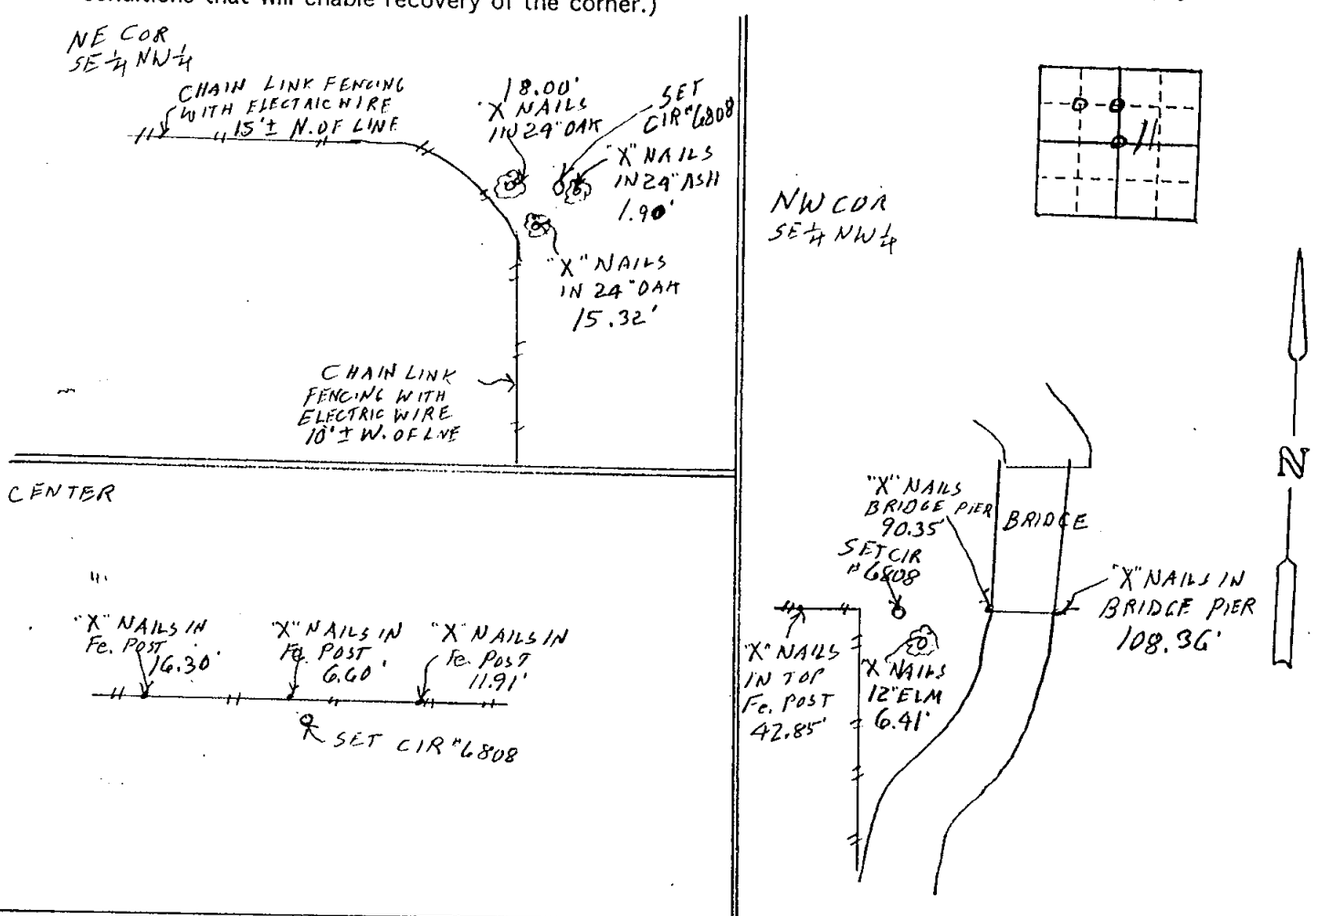

LICENSED LAND SURVEYOR
J. M. HOCHSTETLER
6808
IOWA

I hereby certify that this land surveying document was prepared and the related survey work was performed by me or under my direct personal supervision and that I am a duly licensed Land Surveyor under the laws of the State of Iowa.

J.M. Hochstetler

J.M. HOCHSTETLER
License number 6808 Date 12/12/03.
My license renewal date is December 31, 2003
Pages or sheets covered by this seal: 1

List Corners to be Indexed

Corners	Section	Twp	Range
NE COR SE¼ NW¼	11	76N	29W
CENTER	11	76N	29W
NW COR SE¼ NW¼	11	76N	29W