

MICHELLE "MICKI" UTSLER, COUNTY RECORDER  
 MADISON IOWA

COMPUTER	<input checked="" type="checkbox"/>
RECORDED	<input checked="" type="checkbox"/>
COMPARED	<input type="checkbox"/>

David M. Hiller, 13756 Nevada Street, Indianola, IA 50125 Ph. 515-961-6352


**UNITED STATES PUBLIC SECTION CORNER CERTIFICATE  
 OF**

Land survey monuments situated in Section 4, Township 74 North, Range 26 West of the 5th P.M., Madison County, Iowa.

Previously Recorded in Book - Page -.Found on file in the County Engineer's records.

Found pin with cap #13427. Existing reference ties to the North and the Northeast verified. Reference tie to the Northwest may have been buried or grubbed out by recent driveway construction. Set X nails near ground level in West gate post.

**PLAN VIEW REFERENCE TIES**

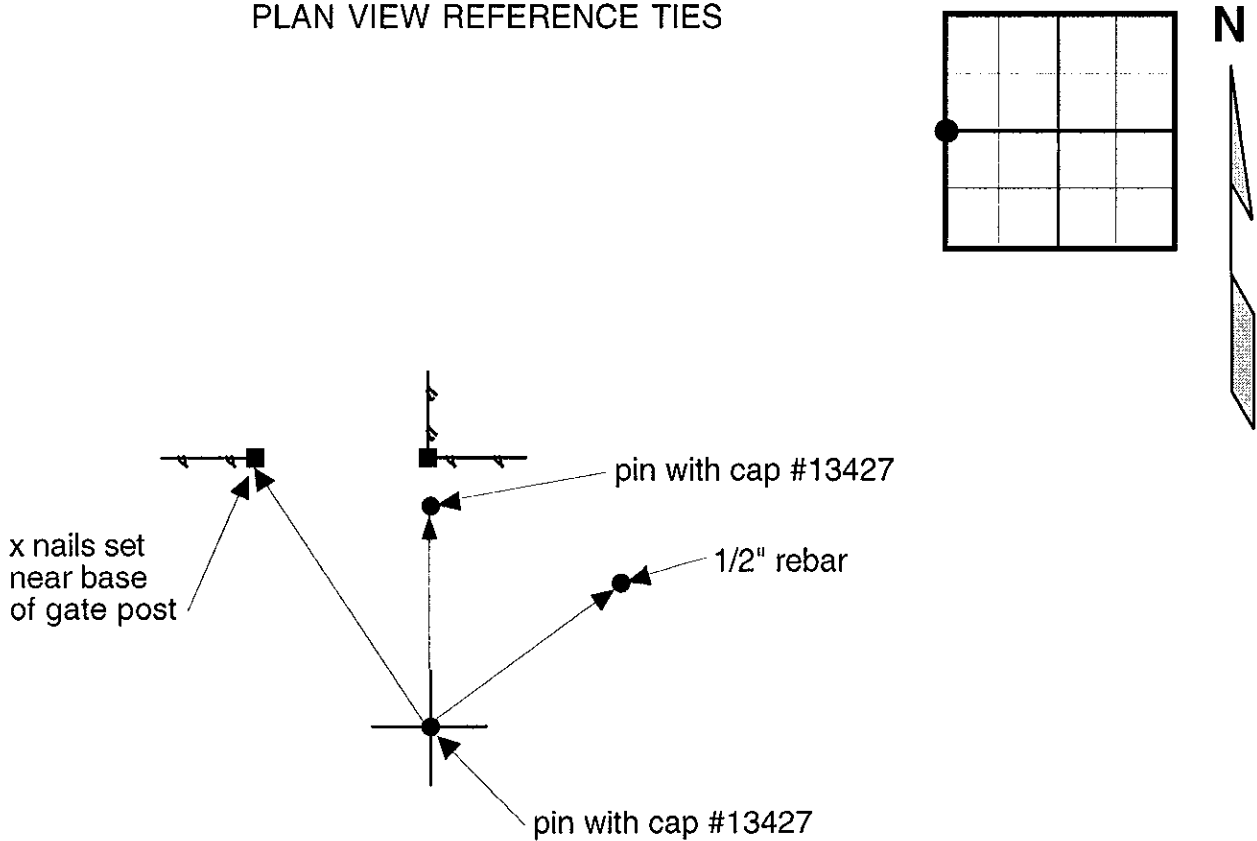

STATE OF IOWA

ss

COUNTY OF MADISON


**LAND CORNERS TO BE RECORDED**

Corners	Sec.	Twp.	Range
W 1/4	4	74	26

I HEREBY CERTIFY THAT THIS LAND SURVEYING DOCUMENT WAS PREPARED AND THE RELATED SURVEY WORK WAS PERFORMED BY ME OR UNDER MY DIRECT PERSONAL SUPERVISION AND THAT I AM A DULY LICENSED LAND SURVEYOR UNDER THE LAWS OF THE STATE OF IOWA.

SIGNATURE: *David M. Hiller* DATE: 6/13/05

DAVID M. HILLER, L.S. IOWA LICENSE #3754  
 MY LICENSE IS DUE FOR RENEWAL DECEMBER 31, 2006  
 THIS CERTIFICATION INCLUDES SHEETS 1 THROUGH 1 OF 1.

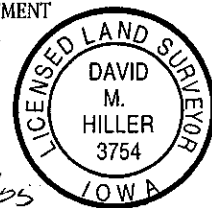

Hiller Engineering Engineering and Surveying INDIANOLA, IOWA	JOHN JONES	DATE 6/13/05
	St. Charles, Iowa	NO SCALE
DRAWN DMH CHECKED dmH	<b>SECTION CORNER CERTIFICATE</b>	DRAWING NO.
APPROVED D. M. Hiller		4302.2-2
		SHEET 1 OF 1