

MICHELLE "MICKI" UTSLER, COUNTY RECORDER
MADISON IOWA

COMPUTER	<input checked="" type="checkbox"/>
RECORDED	<input checked="" type="checkbox"/>
COMPARED	<input type="checkbox"/>

Daniels Land Surveying, 22598 18th Ave, New Virginia, IA 50210, 641-449-3259

UNITED STATES PUBLIC LAND CORNER CERTIFICATE OF

Land Survey Monuments situated in Section 36, Township 74 N, Range 26 W, of the
5th P.M., Madison County, Iowa. Previously recorded in N.A.
in County Recorders Office. (book, page, document number, etc.)


(Show reason for preparing this certificate, the evidence and detailed procedures used in
establishing the corner positions and monumentation found or placed.)

Monument Description and Remarks:

Set 1/2" red plastic capped rebar, #17532 midpoint and online between found
Center of Section and fence corner at W 1/4 Corner.


PLAN VIEW

(Show a minimum of three reference ties to durable physical objects, relevant monuments
and physical conditions that will enable recovery of the corner.)

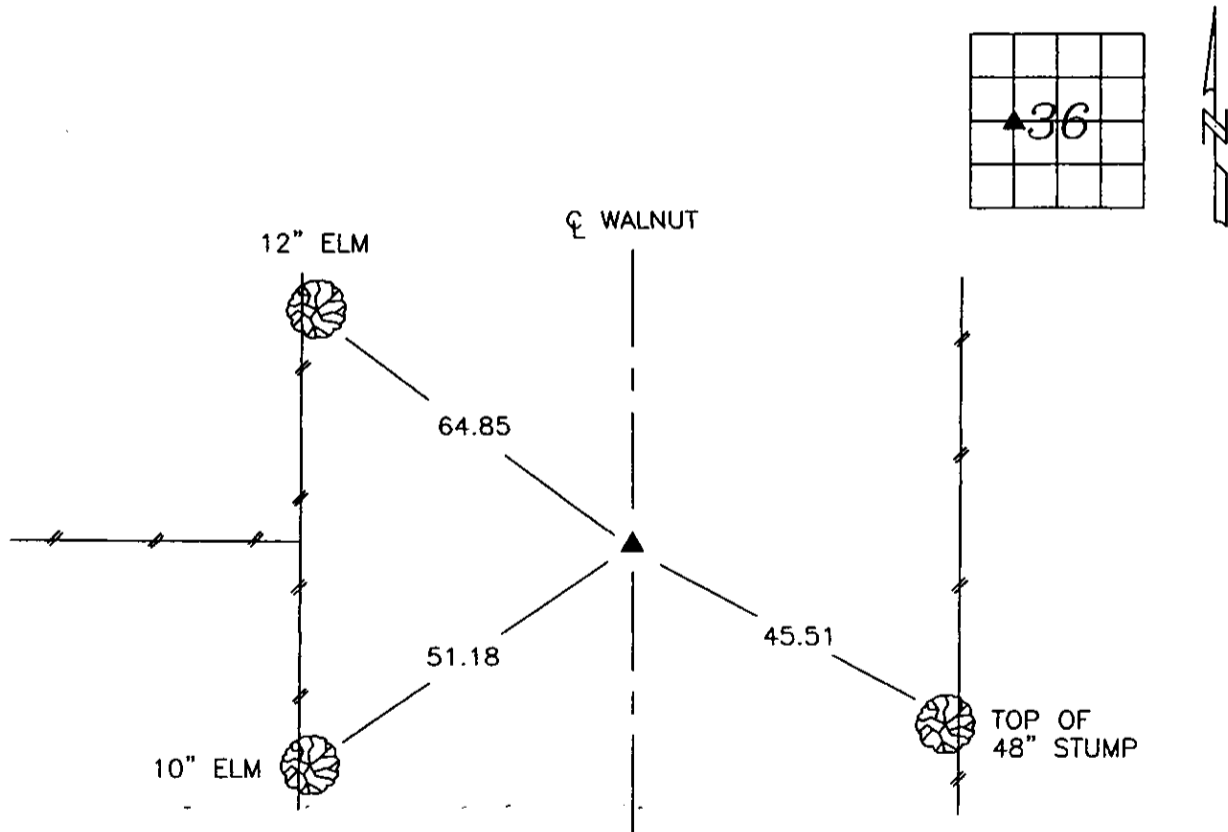

SW COR., SE 1/4, NW 1/4, SEC. 36

ALL TIES 'X' NAILS

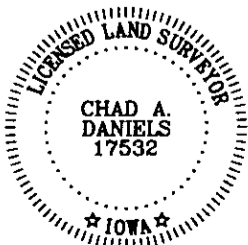

I hereby certify that this land surveying document was prepared and the
related survey work was performed by me or under my direct personal
supervision and that I am a duly licensed Land Surveyor under the laws
of the State of Iowa.

Signature Chad A. Daniels
Chad A. Daniels

Date: 7/5/05

License number 17532
My license renewal date is December 31, 2006

0405-03