


COMPUTER
 RECORDED
 COMPARED

MICHELLE UTSLER, COUNTY RECORDER
 MADISON IOWA

HENRY S. OAKES - OAKES ENGINEERING - 949 65TH STREET - DES MOINES, IA 50312 - (515)255-1777

LEGAL DESCRIPTION: (BOOK 2003/PAGE 3802)

LOT FIVE (5) OF ST. JOHN'S WOODS SUBDIVISION,
 A SUBDIVISION IN THE NORTH HALF (1/2) OF THE
 SOUTHWEST QUARTER (1/4) OF SECTION TWENTY-TWO (22)
 TOWNSHIP SEVENTY-SEVEN (77) NORTH, RANGE TWENTY-SIX
 (26) WEST OF THE 5TH P.M., MADISON COUNTY, IOWA.

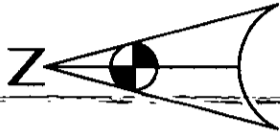


SURVEY FOR OWNER:
 ALLEN C & ANGELA L HANSEN
 3129 38TH COURT
 CUMMING, IOWA.

DATE OF FIELD SURVEY: 7/25/2005
 NO TITLE WORK WAS DONE BY THIS SURVEYOR

NOTES

- DENOTES IRON PIN OR PIPE - FOUND
- DENOTES 1/2" REBAR W/YELLOW CAP #3321 - SET
- M MEASURED
- R RECORDED

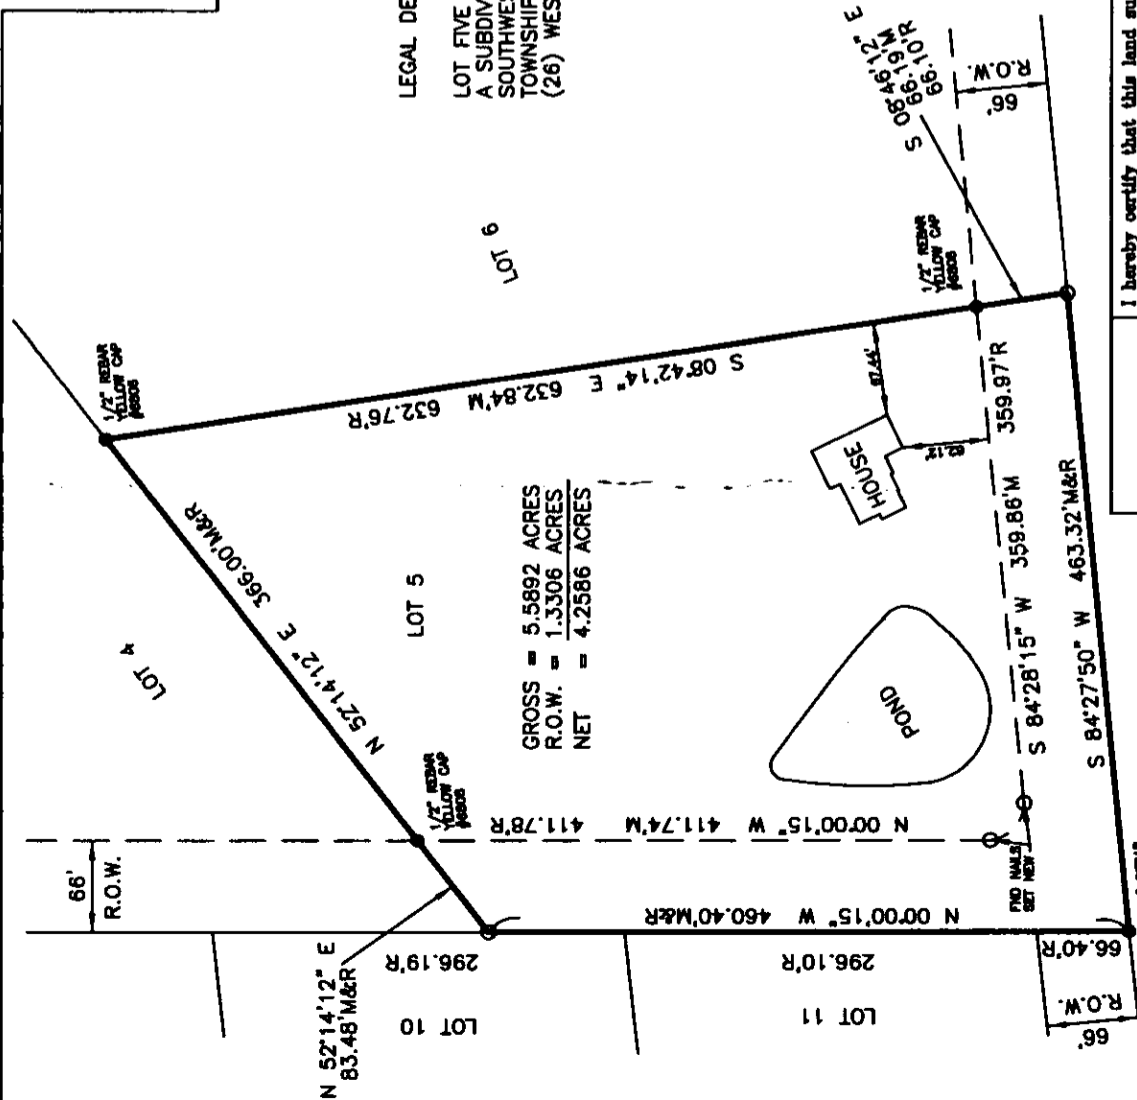

I hereby certify that this land surveying document was prepared and the related survey work was performed by me or under my direct personal supervision and that I am a duly licensed Land Surveyor under the laws of the State of Iowa.

Henry S. Oakes
 Henry S. Oakes
 License number 03321
 My license renewal date is December 31, 2006.
 Pages or sheets covered by this seal: ONE

Date: 9-28-05



BOUNDARY SURVEY
 LOT 5 ST. JOHN'S WOODS

SCALE: 1" = 100' APPROVED BY: _____
 DATE: JULY 2005

DRAWN BY: DDA

OAKES ENGINEERING COMPANY

949 - 65th Street - Des Moines, IOWA 50312
 Tel. (515) 255-1777

DRAWING NUMBER: 2005-B-0214