


MICHELLE UTSLER, COUNTY RECORDER
MADISON IOWA

COMPUTER	<input checked="" type="checkbox"/>
RECORDED	<input checked="" type="checkbox"/>
COMPARED	<input type="checkbox"/>

✓ VANCE & HOCHSTETLER, P.C. CONSULTING ENGINEERS, WINTERSET, IOWA (515) 462-3995
 CHARLES T. VANCE, 110 WEST GREEN ST., WINTERSET, IOWA 50273-1533
 JAMES M HOCHSTETLER, 110 WEST GREEN ST., WINTERSET, IOWA 50273 - 1533


PLAT OF SURVEY IN THE SOUTHWEST QUARTER OF THE NORTHWEST
 QUARTER OF SECTION 2, TOWNSHIP 76 NORTH, RANGE 26 WEST OF THE 5TH
 P.M., MADISON COUNTY, IOWA OWNED BY DONALD LYNCH.

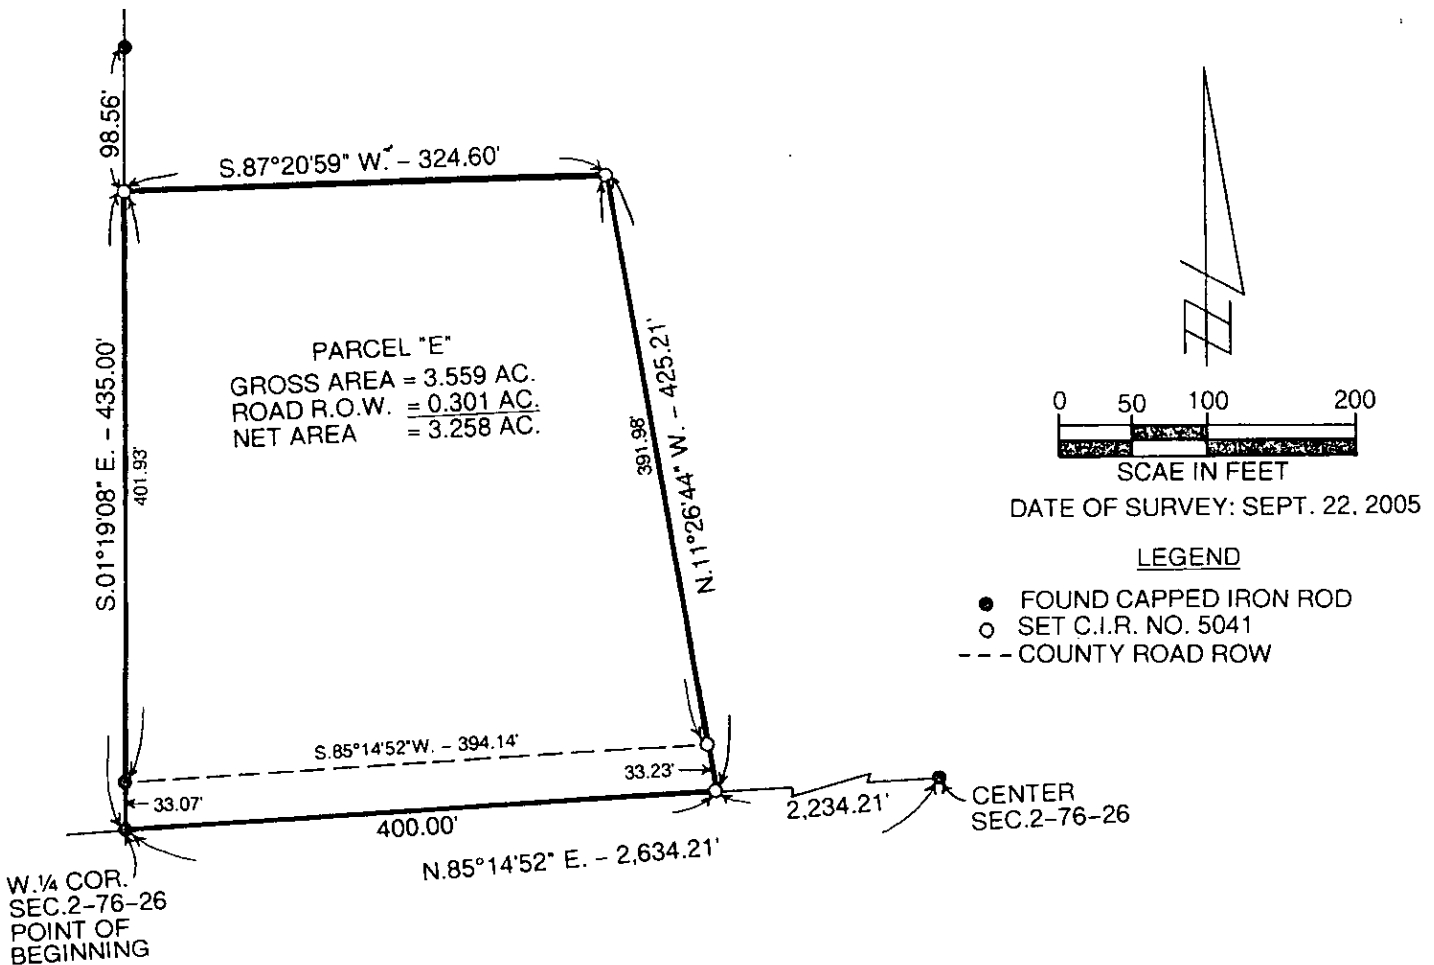

LEGAL DESCRIPTION:

Parcel "E" in the Southwest Quarter of the Northwest Quarter of Section 2, Township 76 North, Range 26 West of the 5th P.M., Madison County, Iowa more particularly described as follows:

Beginning at the West Quarter Corner of Section 2, Township 76 North, Range 26 West of the 5th P.M., Madison County, Iowa; thence North 85°14'52" East 400.00 feet along the South line of the Northwest Quarter of said Section 2; thence North 11°26'44" West 425.21 feet; thence South 87°20'59" West 324.60 feet to the West line of the Southwest Quarter of the Northwest Quarter of said Section 2; thence along said West line South 01°19'08" East 435.00 feet to the Point of Beginning and containing 3.559 acres including 0.301 acres of County Road Right of Way.

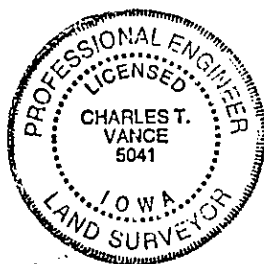

I hereby certify that this engineering or land surveying document was prepared and the related survey work was performed by me or under my direct personal supervision and that I am a duly licensed Professional Engineer and Land Surveyor under the laws of the State of Iowa.

Charles T. Vance 5 Oct. 2005
 Charles T. Vance Date

License number 5041

My license renewal date is December 31, 2005.

Pages or sheets covered by this seal:

one