Document 2006 427

Book 2006 Page 427 Type 06 043 Pages 1
Date 1/30/2006 Time 4:01 PM
Rec Amt $7.00

COMPUTER_____
RECORDED_____
COMPARED_____

MICHELLE UTSLER. COUNTY RECORDER
MADISON IOWA

VANCE & HOCHSTETLER, P.C., CONSULTING ENGINEERS, WINTERSET, IOWA (515) 462-3995
05-2405 Adams CHARLES T. VANCE, 110 West Green St., Winterset, Iowa, 50273
JAMES M HOCHSTETLER, 110 West Green St., Winterset, Iowa 50273


UNITED STATES PUBLIC LAND SURVEY CORNER CERTIFICATE OF


Land Survey Monuments situated in Section 16, Township 76 N, Range 29 W, of the Fifth Principal Meridian, MADISON County, Iowa.
Previously recorded in _____ in County Recorder's Office.
(book, page, document number, etc.)


(Show reason for preparing this certificate, the evidence and detailed procedures used in establishing the the corner positions and monumentation found or placed.)
Monument Description and Remarks: We calculated the center of Section 16 based on the intersection of lines between Quarter Section corners which established the 4 corners at the NE¼ of the Section. Then calculated the Corners by dividing the half miles equally and did an intersect to establish the NW Cor. of the SE¼ of the NE¼.


PLAN - VIEW

(Show a minimum of three reference ties to durable physical objects, relevant monuments and physical conditions that will enable recovery of the corner.)

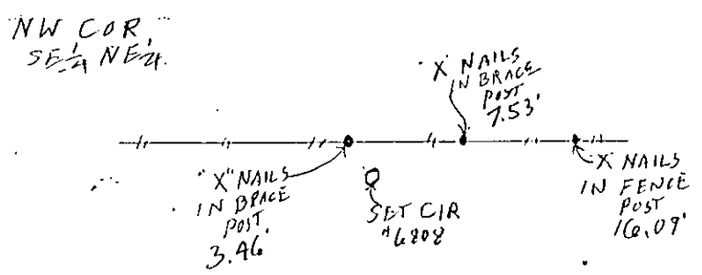

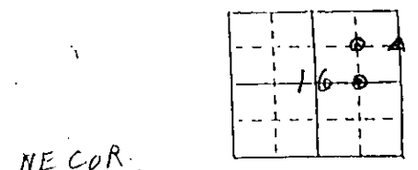

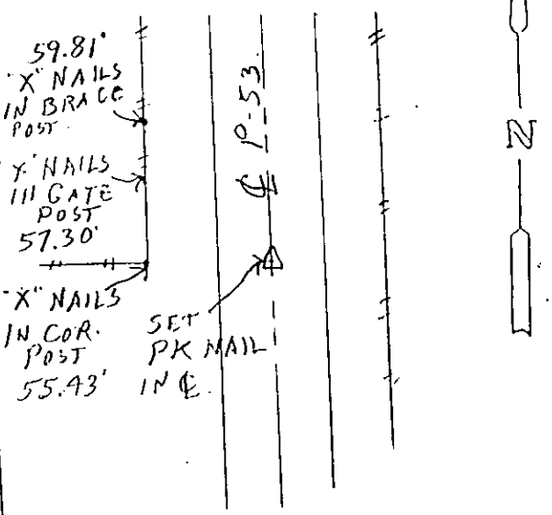

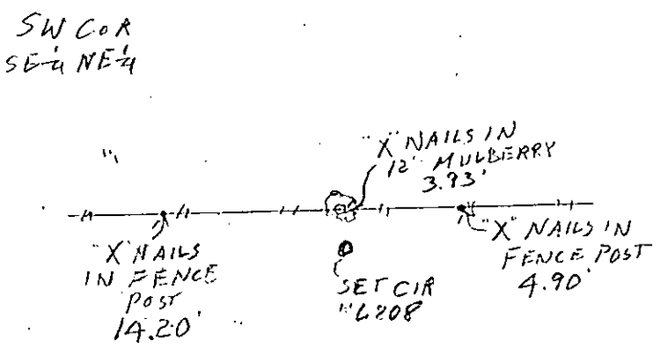



I hereby certify that this land surveying document was prepared and the related survey work was performed by me or under my direct personal supervision and that I am a duly licensed Land Surveyor under the laws of the State of Iowa.

J.M. HOCHSTETLER
License number 6808 Date 12/22/05
My license renewal date is December 31, 2006
Pages or sheets covered by this seal: 1

List Corners to be Indexed

Corners	Section	Twp	Range
NW COR SE¼ NE¼	16	76N	29W
SW COR SE¼ NE¼	16	76N	29W
NE COR SE¼ NE¼	16	76N	29W