Document 2006 1598

Book 2006 Page 1598 Type 06 043 Pages 1
Date 4/25/2006 Time 3:54 PM
Rec Amt $7.00

COMPUTER ✓
RECORDED
COMPARED

MICHELLE UTSLER. COUNTY RECORDER
MADISON IOWA

VANCE & HOCHSTETLER, P.C., CONSULTING ENGINEERS, WINTERSET, IOWA (515) 462-3995
CHARLES T. VANCE, 110 West Green St., Winterset, Iowa, 50273
JAMES M HOCHSTETLER, 110 West Green St., Winterset, Iowa 50273

06-525

UNITED STATES PUBLIC LAND SURVEY CORNER CERTIFICATE

OF

Land Survey Monuments situated in Section 29, Township 75 NORTH, Range 27 WEST, of the Fifth Principal Meridian, MADISON County, Iowa.
Previously recorded in _____ in County Recorder's Office.
(book, page, document number, etc.)

(Show reason for preparing this certificate, the evidence and detailed procedures used in establishing the the corner positions and monumentation found or placed.)


Monument Description and Remarks:


SE cor. NW.1/4 SE.1/4 - Set Capped Iron Rod (1/2" rebar, exposed) #6808 at existing three-way Fence corner.

NE cor. NW.1/4 SE.1/4 - Set C.I.R. #6808 (1/2" rebar, 3" deep) in roadway at the midpoint of a line between the Center of and the East Quarter corner

PLAN - VIEW

(Show a minimum of three reference ties to durable physical objects, relevant monuments and physical conditions that will enable recovery of the corner.)

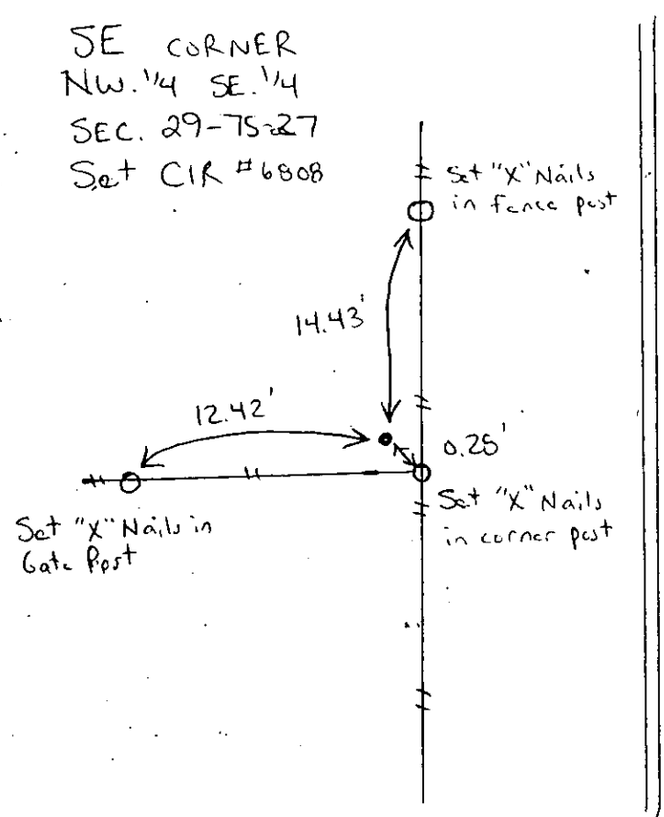

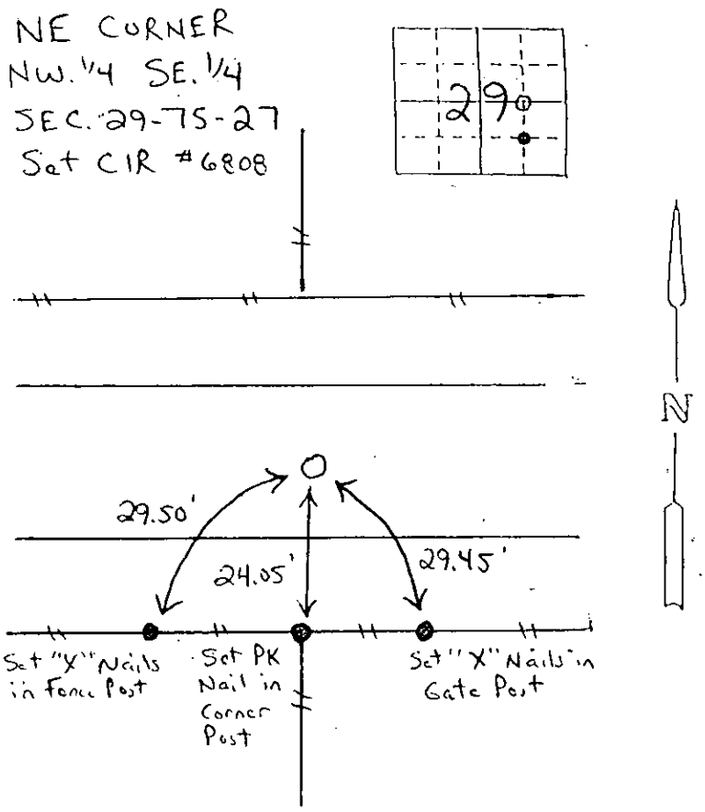



I hereby certify that this land surveying document was prepared and the related survey work was performed by me or under my direct personal supervision and that I am a duly licensed Land Surveyor under the laws of the State of Iowa.

J.M. HOCHSTETLER
License number 6808 Date 4/15/06
My license renewal date is December 31, 2007
Pages or sheets covered by this seal: 1

List Corners to be Indexed

Corners	Section	Twp	Range
SE cor NW.1/4 SE.1/4	29	75N	27W
NE cor NW.1/4 SE.1/4	29	75N	27W