Document 2006 1733
Book 2006 Page 1733 Type 06 043 Pages 1
Date 5/02/2006 Time 1:22 PM
Rec Amt $7.00

COMPUTER ✓
RECORDED ✓
COMPARED

MICHELLE UTSLER. COUNTY RECORDER
MADISON IOWA

Prepared By: J. Brian Morrissey, Morrissey Surveying, 1405 Hwy. G28, Otley, Ia. 50214, Tel. (641) 627-5554

UNITED STATES PUBLIC LAND SURVEY CORNER CERTIFICATE OF

Land Survey Monuments situated in Section 4, Township 76N, Range 27W, of the Fifth Principal Meridian, Madison County,Iowa.
Previously recorded in N.A. in County Recorders Office.


(book, page, document number,etc.)

(Show reason for preparing this certificate, the evidence and detailed procedures used in establishing the corner positions and monumentation found or placed.)

Monument Description and Remarks: Set 5/8" x 18" orange capped rebar #7995 at intersection of line from N. and S. 1/4 corners and line from NE. Cor., SE. 1/4 to NW. Cor. NE. 1/4 of the SE. 1/4.

PLAN VIEW

(Show a minimum of three reference ties to durable physical objects, relevant monuments and physical conditions that will enable recovery of the corner.)

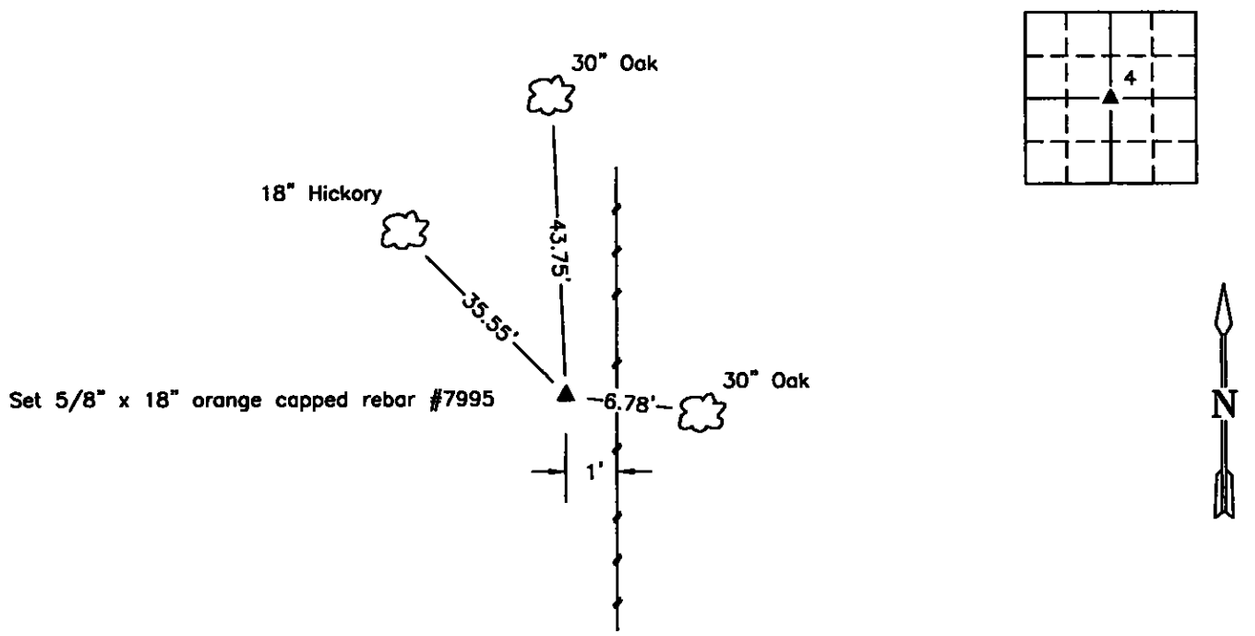

NW COR SE 1/4 SEC 4

NOTE: ALL TIES TO "X" NAILS UNLESS NOTED.

LICENSED PROFESSIONAL ENGINEER & LAND SURVEYOR
J.BRIAN MORRISSEY 7995
IOWA

I hereby certify that the survey work was completed and this certificate was prepared by me or under my direct personal supervision and that I am a duly Licensed Land Surveyor under the laws of the State of Iowa.

Signature: J. Brian Morrissey Date: 4/29/06
J. Brian Morrissey

License number 7995.
My license renewal date is December 31, 2007

502-05-2