Document 2006 1855

Book 2006 Page 1855 Type 06 043 Pages 1
Date 5/10/2006 Time 11:27 AM
Rec Amt $7.00

COMPUTER ✓
RECORDED ✓
COMPARED

MICHELLE UTSLER. COUNTY RECORDER
MADISON IOWA

VANCE & HOCHSTETLER, P.C., CONSULTING ENGINEERS, WINTERSET, IOWA (515) 462-3995
CHARLES T. VANCE, 110 West Green St., Winterset, Iowa, 50273
JAMES M HOCHSTETLER, 110 West Green St., Winterset, Iowa 50273

06-455

# UNITED STATES PUBLIC LAND SURVEY CORNER CERTIFICATE OF


Land Survey Monuments situated in Section 8, Township 74 N, Range 26 W, of the Fifth Principal Meridian, MADISON County, Iowa.
Previously recorded in _____ (book, page, document number, etc.) in County Recorder's Office.

(Show reason for preparing this certificate, the evidence and detailed procedures used in establishing the corner positions and monumentation found or placed.)

Monument Description and Remarks: NE COR - Set yellow CIR "6808 exposed in old N&S. fence line equal distance from the E¼ Cor Sec. 5 & E¼ Cor. Sec. 8 both certified Corners. Notes in old survey field book at Co. Engr. office indicate a stone at this Corner tied to two trees & in a fence line. We found a limestone rock wedged against a brace post N. of an old fence line E. but it was approximately 50 feet South of the midpoint between the E¼ Cor. of Sec. 8 and E¼ Cor. Sec. 5. and we could not find any evidence of referenced trees.

## PLAN - VIEW

(Show a minimum of three reference ties to durable physical objects, relevant monuments and physical conditions that will enable recovery of the corner.)

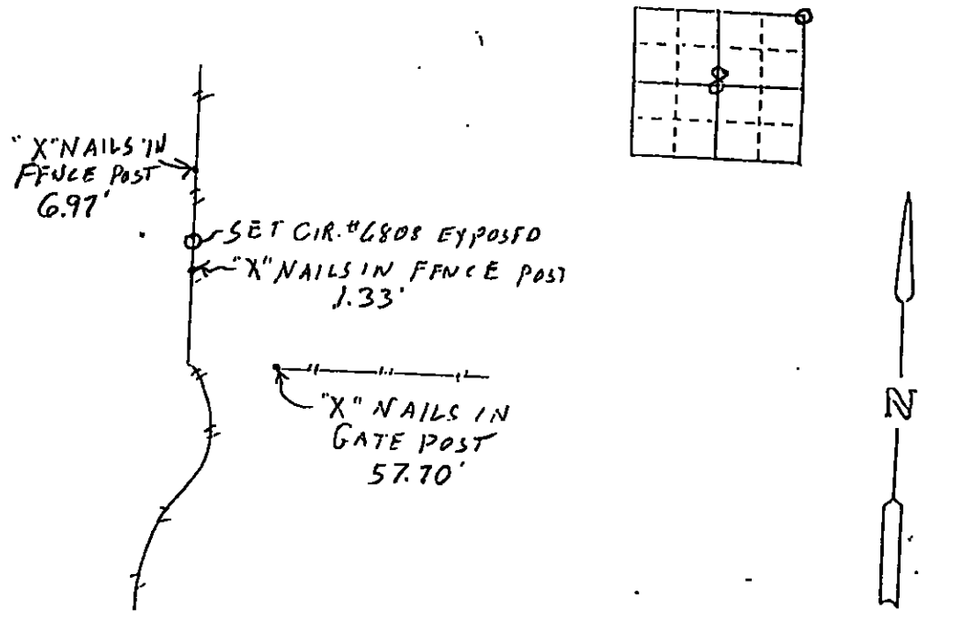


LICENSED LAND SURVEYOR
J. M. HOCHSTETLER
#6808
IOWA

I hereby certify that this land surveying document was prepared and the related survey work was performed by me or under my direct personal supervision and that I am a duly licensed Land Surveyor under the laws of the State of Iowa.

J.M. Hochstetler

J.M. HOCHSTETLER
License number 6808 Date 4/14/06
My license renewal date is December 31, 2007
Pages or sheets covered by this seal: 1

List Corners to be Indexed

| Corners | Section | Twp | Range |
|---|---|---|---|
| NE COR. | 8 | 74N | 26W |