Document 2006 3080
Book 2006 Page 3080 Type 06 043 Pages 1
Date 7/27/2006 Time 3:47 PM
Rec Amt $7.00

MICHELLE UTSLER. COUNTY RECORDER
MADISON IOWA

VANCE & HOCHSTETLER, P.C., CONSULTING ENGINEERS, WINTERSET, IOWA (515) 462-3995
06-785 CHARLES T. VANCE, 110 West Green St., Winterset, Iowa, 50273
JAMES M HOCHSTETLER, 110 West Green St., Winterset, Iowa 50273

COMPUTER ✓
RECORDED ✓
COMPARED


UNITED STATES PUBLIC LAND SURVEY CORNER CERTIFICATE
OF

Land Survey Monuments situated in Section 21, Township 74 N, Range 26 W, of the Fifth Principal Meridian, MADISON County, Iowa.
Previously recorded in _____ in County Recorder's Office.
(book, page, document number, etc.)

(Show reason for preparing this certificate, the evidence and detailed procedures used in establishing the the corner positions and monumentation found or placed.)
Monument Description and Remarks: SE COR SW¼SE¼ - Found CIR #13927 set by Boldman Land Surveying but not certified. Based on our measurements it was set at the midpoint on line between found corners at the SE Cor. & S¼ Cor of Section. NE COR. SW¼SE¼ - Set CIR #6808 at midpoint on line between found corners at the NE Cor of SE¼SE¼ and NW Cor. SW¼SE¼ of Section

PLAN - VIEW

(Show a minimum of three reference ties to durable physical objects, relevant monuments and physical conditions that will enable recovery of the corner.)

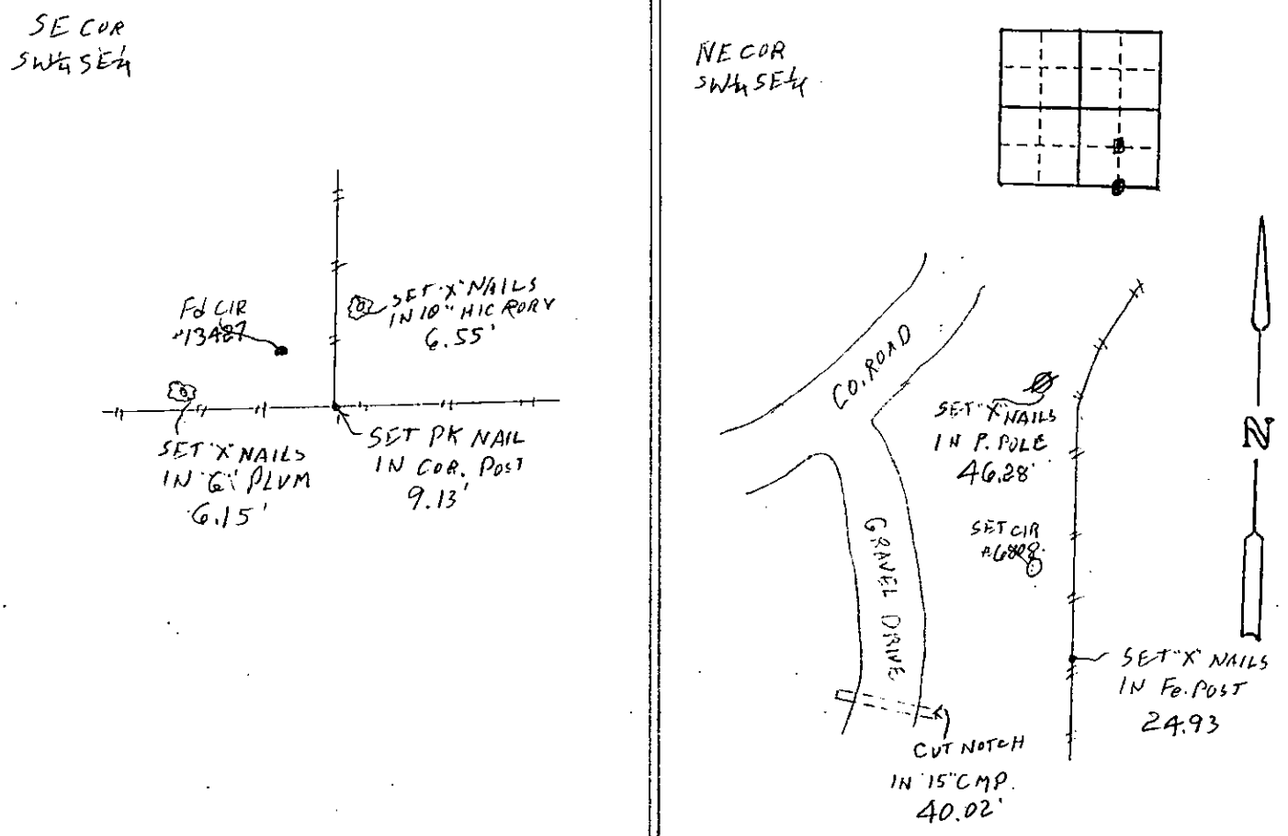

I hereby certify that this land surveying document was prepared and the related survey work was performed by me or under my direct personal supervision and that I am a duly licensed Land Surveyor under the laws of the State of Iowa.

J.M. HOCHSTETLER
License number 6808 Date 6/30/06
My license renewal date is December 31, 2007
Pages or sheets covered by this seal: 1

LICENSED LAND SURVEYOR J. M. HOCHSTETLER #6808 IOWA

List Corners to be Indexed

Corners	Section	Twp	Range
SE COR SW¼SE¼	21	74N	26W
NE COR SW¼SE¼	21	74N	26W