Document 2006 3400

Book 2006 Page 3400 Type 06 043 Pages 1
Date 8/17/2006 Time 10:50 AM
Rec Amt $7.00

COMPUTER ✓
RECORDED ✓
COMPARED

MICHELLE UTSLER. COUNTY RECORDER
MADISON IOWA

VANCE & HOCHSTETLER, P.C., CONSULTING ENGINEERS, WINTERSET, IOWA (515) 462-3995
06-865 CHARLES T. VANCE, 110 West Green St., Winterset, Iowa, 50273
JAMES M HOCHSTETLER, 110 West Green St., Winterset, Iowa 50273

# UNITED STATES PUBLIC LAND SURVEY CORNER CERTIFICATE

OF

Land Survey Monuments situated in Section 22, Township 74 NORTH, Range 28 WEST, of the Fifth Principal Meridian, MADISON County, Iowa.
Previously recorded in _____ in County Recorder's Office.
(book, page, document number, etc.)

(Show reason for preparing this certificate, the evidence and detailed procedures used in establishing the the corner positions and monumentation found or placed.)


Monument Description and Remarks:

NW cor. SE.1/4 NE.1/4 - Set Capped Iron Rod (1/2" rebar, exposed) #6808 at fence split in line with property line fence to the North.
SW cor. NE.1/4 SE.1/4 - Set Capped Iron Rod (1/2" Iron Rod, 3" deep) #6808 at road R.O.W. split in line with property line fence to the West.


## PLAN - VIEW


(Show a minimum of three reference ties to durable physical objects, relevant monuments and physical conditions that will enable recovery of the corner.)


NW CORNER
SE.1/4 NE.1/4
SEC. 22-74-28
Set C.I.R. #6808

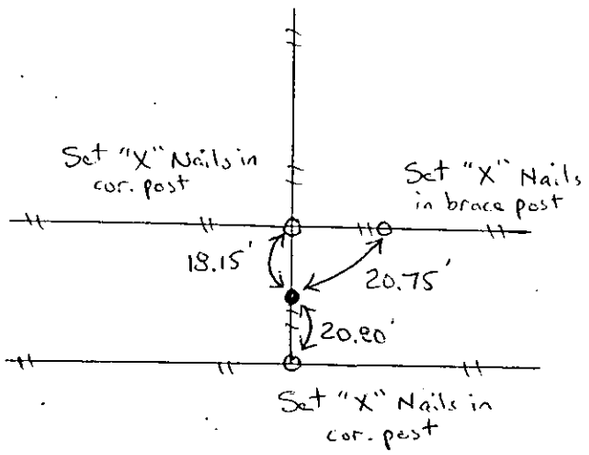


SW CORNER
NE.1/4 SE.1/4
SEC. 22-74-28
Set C.I.R. #6808

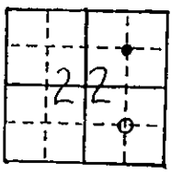

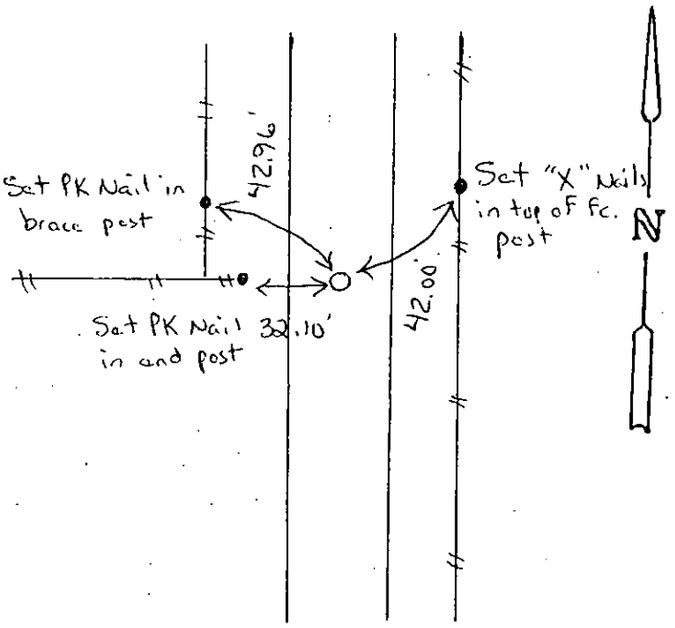
I hereby certify that this land surveying document was prepared and the related survey work was performed by me or under my direct personal supervision and that I am a duly licensed Land Surveyor under the laws of the State of Iowa.

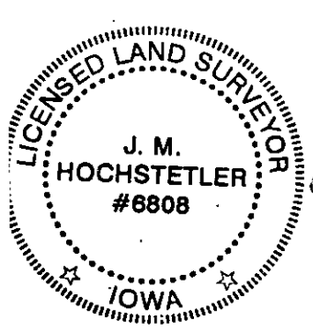J. M. Hochstetler

J.M. HOCHSTETLER
License number 6808 Date 8/14/06
My license renewal date is December 31, 2007
Pages or sheets covered by this seal: 1

List Corners to be Indexed

| Corners | Section | Twp | Range |
|---|---|---|---|
| NW cor SE.1/4 NE.1/4 | 22 | 74 | 28 |
| SW cor NE.1/4 SE.1/4 | 22 | 74 | 28 |