Document 2006 3401

Book 2006 Page 3401 Type 06 043 Pages 1
Date 8/17/2006 Time 10:50 AM
Rec Amt $7.00

COMPUTER ✓
RECORDED ✓
COMPARED

MICHELLE UTSLER. COUNTY RECORDER
MADISON IOWA

VANCE & HOCHSTETLER, P.C., CONSULTING ENGINEERS, WINTERSET, IOWA (515) 462-3995
06-1205 CHARLES T. VANCE, 110 West Green St., Winterset, Iowa, 50273
JAMES M HOCHSTETLER, 110 West Green St., Winterset, Iowa 50273

UNITED STATES PUBLIC LAND SURVEY CORNER CERTIFICATE OF

Land Survey Monuments situated in Section 13, Township 76 N, Range 26W, of the Fifth Principal Meridian, MADISON County, Iowa.
Previously recorded in _____ in County Recorder's Office.
(book, page, document number, etc.)


(Show reason for preparing this certificate, the evidence and detailed procedures used in establishing the the corner positions and monumentation found or placed.)

Monument Description and Remarks: SE Cor. SWFr¼SW¼ - Set yellow CIR "6808 at 3 way property line fence corner. The point is approximately 8 feet North of a line between the Certified SE Cor. and property line fence lines East and West at the SW Cor.

NE Cor. NWFr¼SW¼ - Set yellow CIR "6808 at West Corner Post which allows for the one acre parcel on the West line of the NEFr¼SW¼. The line between the SE Cor SWFr¼SW¼ & the NEFr¼SW¼ matches the point used for ROW IN 1964.

PLAN - VIEW

(Show a minimum of three reference ties to durable physical objects, relevant monuments and physical conditions that will enable recovery of the corner.)

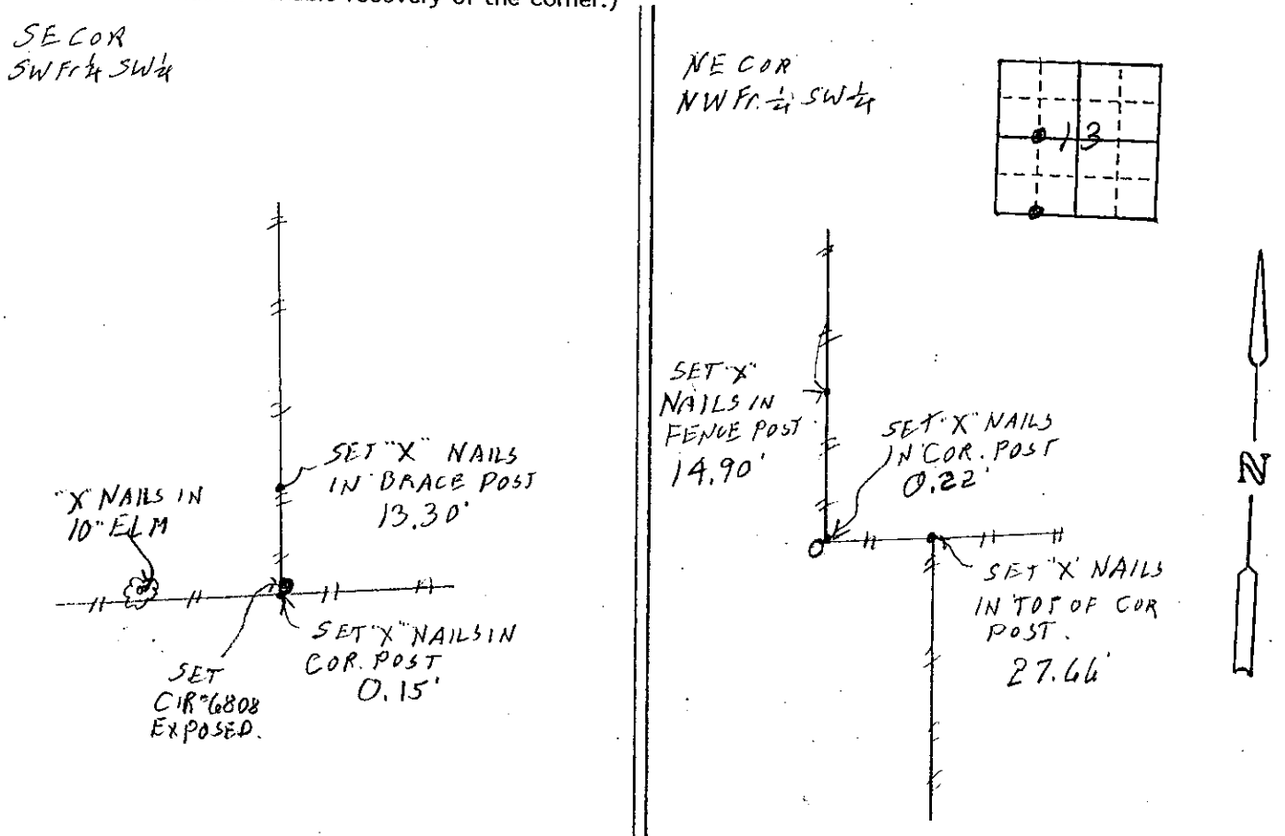

List Corners to be Indexed

Corners	Section	Twp	Range
SE COR SWFr¼SW¼	13	76N	26W
NE COR NWFr¼SW¼	13	76N	26W

LICENSED LAND SURVEYOR
J. M. HOCHSTETLER #6808
IOWA

I hereby certify that this land surveying document was prepared and the related survey work was performed by me or under my direct personal supervision and that I am a duly licensed Land Surveyor under the laws of the State of Iowa.

J.M. HOCHSTETLER
License number 6808 Date 8/17/06.
My license renewal date is December 31, 2007
Pages or sheets covered by this seal: