COMPUTER ✓
RECORDED ✓
COMPARED ✓

Document 2006 4352
Book 2006 Page 4352 Type 06 043 Pages 1
Date 10/23/2006 Time 10:53 AM
Rec Amt $7.00

MICHELLE UTSLER. COUNTY RECORDER
MADISON IOWA

RETURN TO : BOLDMAN LAND SURVEYING, P.C., BOX 66, WINTERSET,IA 50273 515-462-9242

UNITED STATES PUBLIC LAND SURVEY CORNER CERTIFICATE

OF

Land Survey Monuments situated in Section 9, Township 74, Range 28, of the Fifth Principal Meridian, Madison County, Iowa
Previously recorded in Not found In County Recorder's Office.
(book, page, document number, etc.)


(show reason for preparing this certificate, the evidence and detailed procedures used in establishing the corner positions and monumentation found or placed.)


Monument Description and Remarks: As shown

All tied to pk nail and orange washer (New) unless noted otherwise


PLAN-VIEW

(Show a minimum of three reference ties to durable physical objects, relevant monuments and physical conditions that will enable recovery of the corner.)

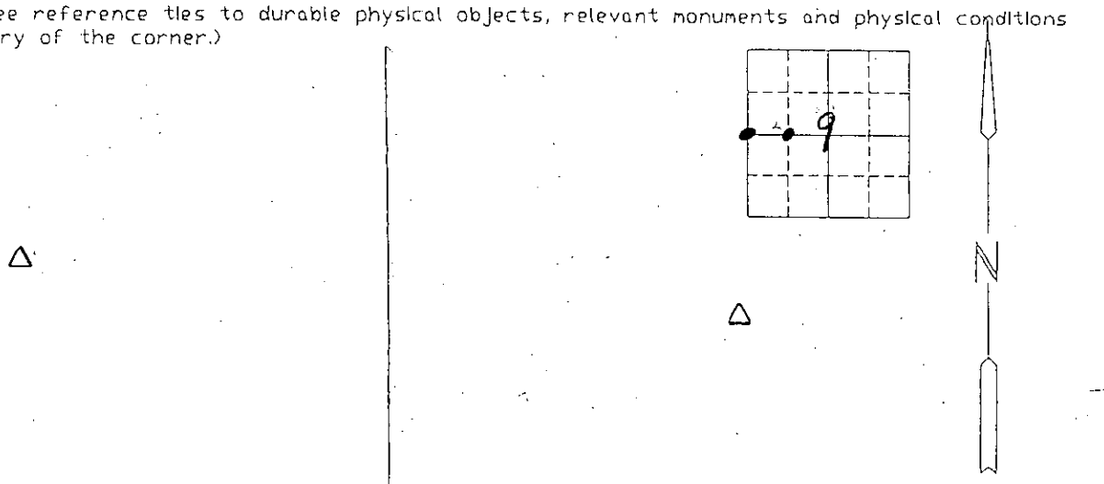

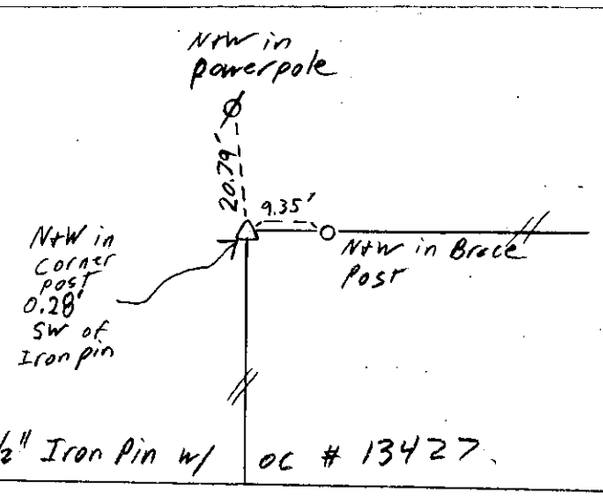

W 1/4
set 1/2" Iron Pin w/ oc # 13427.

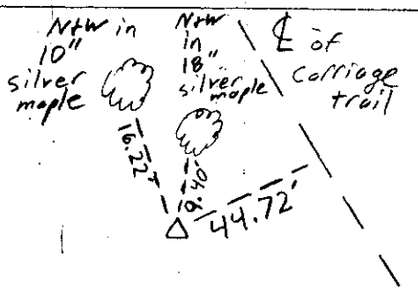

S 1/4 NW 1/4
set 1/2" Iron pin with oc # 13427

I hereby certify that the survey work was completed and this certificate was prepared by me or under my direct personal supervision and that I am a duly Licensed Land Surveyor under the laws of the State of Iowa

Signature: Craig S. Boldman
Craig S. Boldman

Date: 10/24/06 Reg. No. 13427

SEAL

LICENSED LAND SURVEYOR
Expires
CRAIG S. BOLDMAN
13427
12/31/06
IOWA

List Corners to be Indexed

Corners	Section	Twp	Range
W 1/4	9	74	28
S 1/4 NW 1/4	9	74	28

Project # 06053