Document 2006 4373
Book 2006 Page 4373 Type 06 043 Pages 1
Date 10/23/2006 Time 3:01 PM
Rec Amt $7.00

COMPUTER ✓
RECORDED ✓
COMPARED

MICHELLE UTSLER. COUNTY RECORDER
MADISON IOWA

VANCE & HOCHSTETLER, P.C., CONSULTING ENGINEERS, WINTERSET, IOWA (515) 462-3995
06-100S CHARLES T. VANCE, 110 West Green St., Winterset, Iowa, 50273
JAMES M HOCHSTETLER, 110 West Green St., Winterset, Iowa 50273

UNITED STATES PUBLIC LAND SURVEY CORNER CERTIFICATE OF

Land Survey Monuments situated in Section 32, Township T75NORTH, Range 28WEST, of the Fifth Principal Meridian, MADISON County, Iowa.
Previously recorded in _____ in County Recorder's Office.
(book, page, document number, etc.)

(Show reason for preparing this certificate, the evidence and detailed procedures used in establishing the the corner positions and monumentation found or placed.)

Monument Description and Remarks:


NW cor. SW.1/4 NW.1/4 - Set Capped Iron Rod #6808 (1/2" rebar, exposed) at existing 4-way fence corner

NE cor. SW.1/4 NW.1/4 - Set Capped Iron Rod #6808 (1/2" rebar, 3" deep) at county road right-of-way split in line with the existing property line fence to the West.


PLAN - VIEW


(Show a minimum of three reference ties to durable physical objects, relevant monuments and physical conditions that will enable recovery of the corner.)


NW CORNER
SW.1/4 NW.1/4
Sec. 32-75-28
Set C.I.R. #6808

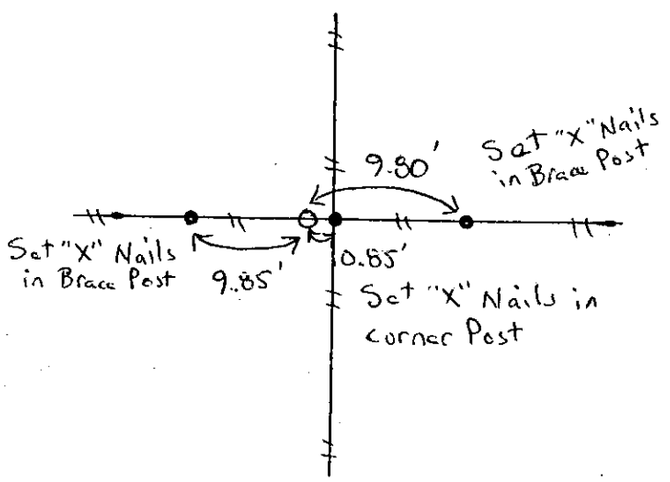

NE CORNER
SW.1/4 NW.1/4
Sec. 32-75-28
Set C.I.R. #6808

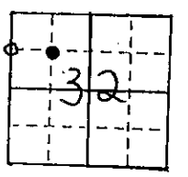

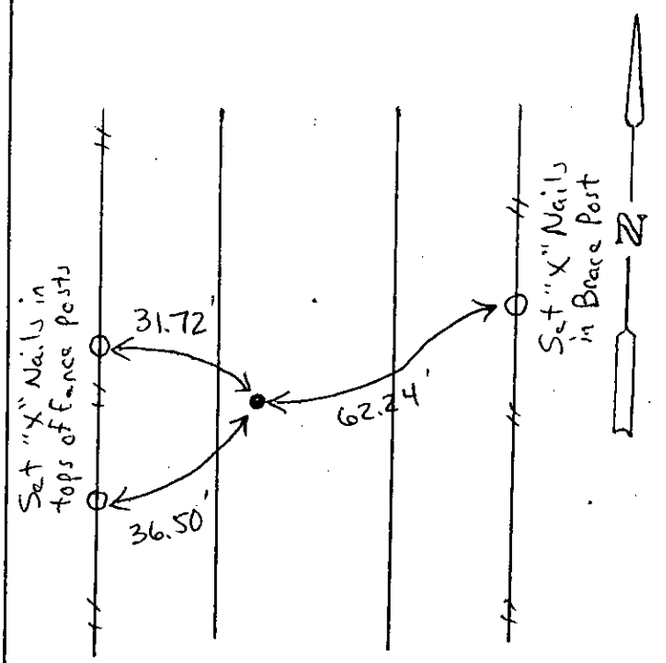

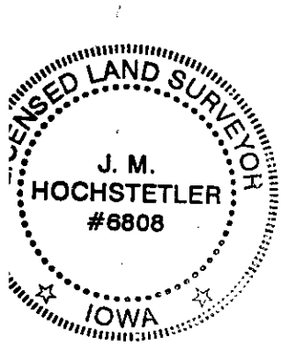

I hereby certify that this land surveying document was prepared and the related survey work was performed by me or under my direct personal supervision and that I am a duly licensed Land Surveyor under the laws of the State of Iowa.

J.M. HOCHSTETLER
License number 6808 Date 10/23/06
My license renewal date is December 31, 2007
Pages or sheets covered by this seal: 1

List Corners to be Indexed

Corners	Section	Twp	Range
NW cor SW.1/4 NW.1/4	32	T75N	R28W
NE cor SW.1/4 NW.1/4	32	T75N	R28W