
Document 2006 4397

Book 2006 Page 4397 Type 06 026 Pages 2 Date 10/24/2006 9:40 AM Time Rec Amt \$12.00


MICHELLE UTSLER. COUNTY RECORDER MADISON IOWA

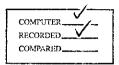

1

CALCULATED POINT (NOTHING SET)

PT CURVE END

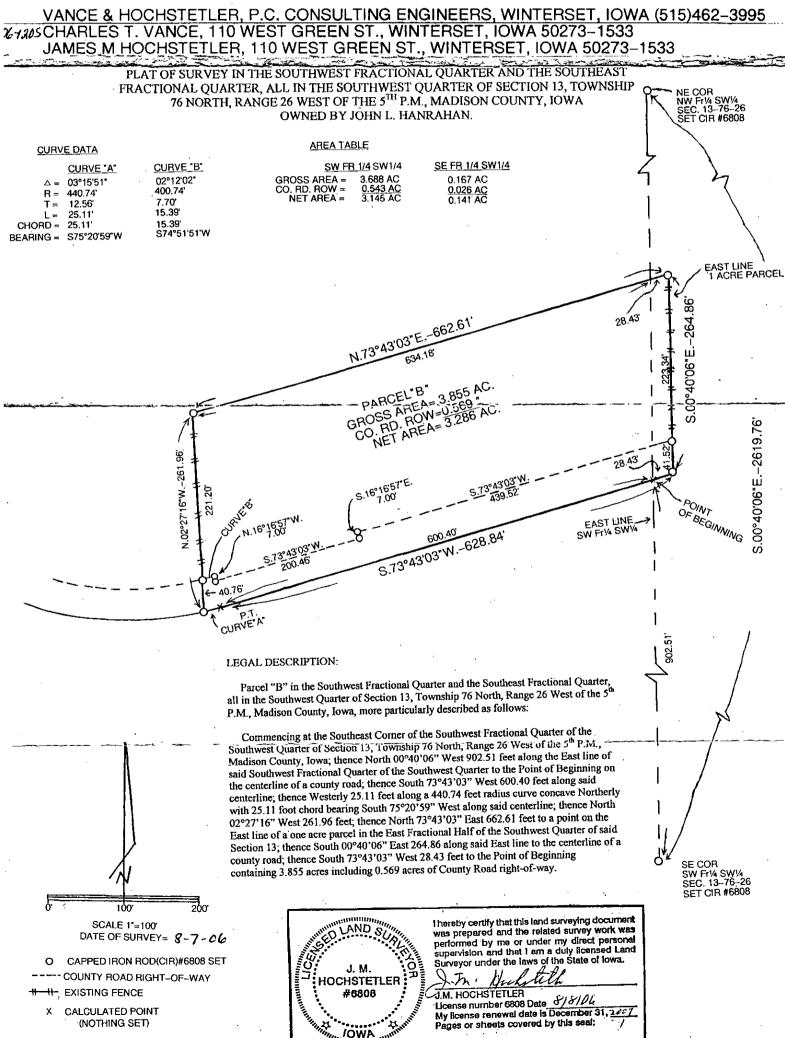

"/OWA

City of Bevington P.O. Box 36 Bevington, Iowa 50033

October 13, 2006

Vance & Hochstetler 110 West Green Street Winterset, Iowa 50273

Dear Vance & Hochstetler;

The Bevington City Council met during their regular scheduled City Council meeting on October 11, 2006, and discussed the two survey plats sent to the City of Bevington due to being within two miles of the city. The Council approved of the survey plats submitted for Mr. Hanrahan and Mr. Bown by Vance & Hochstetler.

Sincerely,

Kathy Kieler, City Clerk