Document 2006 3758

Book 2006 Page 3758 Type 06 043 Pages 1
Date 9/12/2006 Time 2:59 PM
Rec Amt $7.00

MICHELLE UTSLER, COUNTY RECORDER
MADISON IOWA

VANCE & HOCHSTETLER, P.C., CONSULTING ENGINEERS, WINTERSET, IOWA (515) 462-3995
06-145s CHARLES T. VANCE, 110 West Green St., Winterset, Iowa, 50273
JAMES M HOCHSTETLER, 110 West Green St., Winterset, Iowa 50273

COMPUTER ✓
RECORDED ✓
COMPARED

UNITED STATES PUBLIC LAND SURVEY CORNER CERTIFICATE

OF

Land Survey Monuments situated in Section 21, Township 74 NORTH, Range 28 WEST, of the Fifth Principal Meridian, MADISON County, Iowa.
Previously recorded in _____ in County Recorder's Office.
(book, page, document number, etc.)

(Show reason for preparing this certificate, the evidence and detailed procedures used in establishing the the corner positions and monumentation found or placed.)


Monument Description and Remarks:

SW cor. NE.1/4 NE.1/4 - Set Capped Iron Rod #6808 (1/2" rebar, set 3" deep) at the midpoint of a line between the SE cor. NE.1/4 NE.1/4 & a road R.O.W. split in line with a property line fence to the North @ the SW cor. NW.1/4 NE.1/4
SE cor. NE.1/4 NE.1/4 - Set C.I.R. #6808 (1/2" rebar, 3" deep) at the road R.O.W. split in line with the property line fence to the North


PLAN - VIEW


(Show a minimum of three reference ties to durable physical objects, relevant monuments and physical conditions that will enable recovery of the corner.)

SW CORNER
NE.1/4 NE.1/4
SEC. 21-74-28
Set C.I.R. #6808

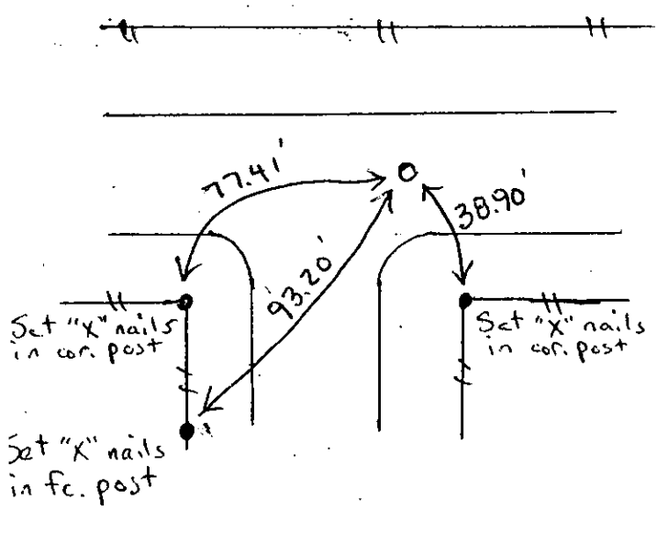

SE CORNER
NE.1/4 NE.1/4
SEC. 21-74-28
Set C.I.R. #6808

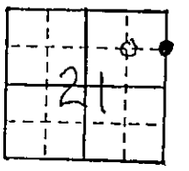

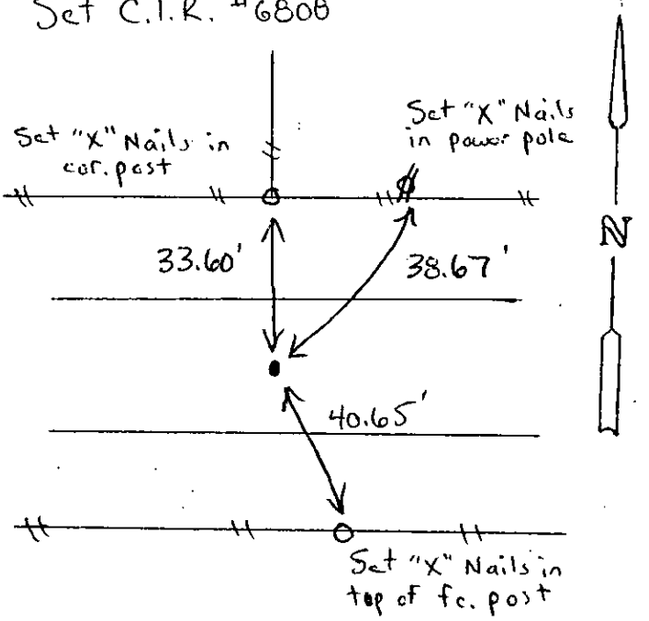

LICENSED LAND SURVEYOR
J. M. HOCHSTETLER
#6808
IOWA

I hereby certify that this land surveying document was prepared and the related survey work was performed by me or under my direct personal supervision and that I am a duly licensed Land Surveyor under the laws of the State of Iowa.

J.M. HOCHSTETLER
License number 6808 Date 8/30/06
My license renewal date is December 31, 2007
Pages or sheets covered by this seal: 1

List Corners to be Indexed

Corners	Section	Twp	Range
SW corner NE.1/4 NE.1/4	21	74N	28W
SE corner NE.1/4 NE.1/4	21	74N	28W