Document 2006 5070

Book 2006 Page 5070 Type 06 043 Pages 1
Date 12/06/2006 Time 3:28 PM
Rec Amt $7.00

COMPUTER ✓
RECORDED ✓
COMPARED

MICHELLE UTSLER, COUNTY RECORDER
MADISON IOWA

VANCE & HOCHSTETLER, P.C., CONSULTING ENGINEERS, WINTERSET, IOWA (515) 462-3995
06-1895 CHARLES T. VANCE, 110 West Green St., Winterset, Iowa, 50273
JAMES M HOCHSTETLER, 110 West Green St., Winterset, Iowa 50273

# UNITED STATES PUBLIC LAND SURVEY CORNER CERTIFICATE

OF


Land Survey Monuments situated in Section 26, Township 77 N, Range 28 W, of the Fifth Principal Meridian, MADISON County, Iowa.
Previously recorded in _____ in County Recorder's Office.
(book, page, document number, etc.)


(Show reason for preparing this certificate, the evidence and detailed procedures used in establishing the the corner positions and monumentation found or placed.)

Monument Description and Remarks: NE COR NW¼ NW¼ - Calculated Corner at mid point between found NW Cor and N¼ Cor lands in North Branch River so we set a witness corner 30.00 feet North of the True Corner. N¼ Cor. - Found CIR # 5899 Set by Rash and shown on a plat of survey in 1999 but could not find filed ties.

## PLAN - VIEW

(Show a minimum of three reference ties to durable physical objects, relevant monuments and physical conditions that will enable recovery of the corner.)

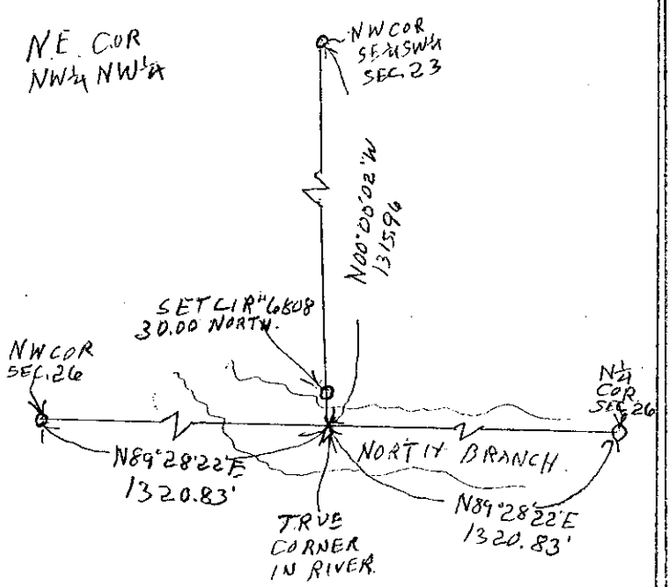

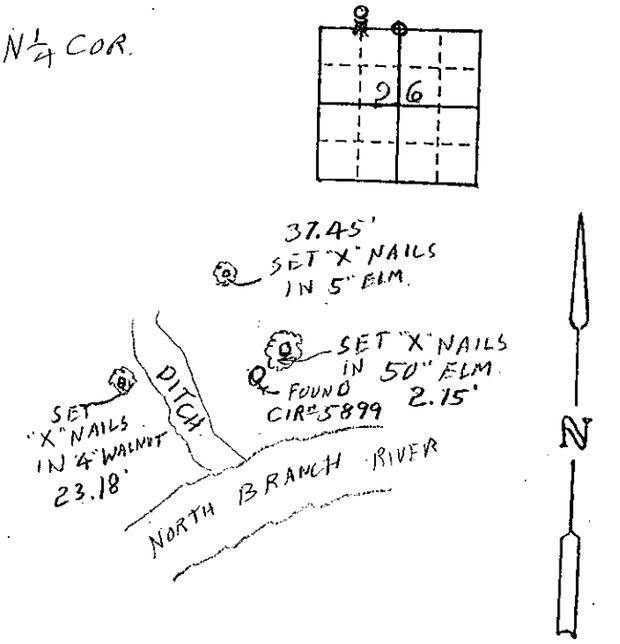
I hereby certify that this land surveying document was prepared and the related survey work was performed by me or under my direct personal supervision and that I am a duly licensed Land Surveyor under the laws of the State of Iowa.

J.M. HOCHSTETLER

License number 6808 Date 12/11/06

My license renewal date is December 31 2007

Pages or sheets covered by this seal: 1

LICENSED LAND SURVEYOR
J. M. HOCHSTETLER
#6808
IOWA

List Corners to be Indexed

| Corners | Section | Twp | Range |
|---|---|---|---|
| NE COR NW¼ NW¼ | 26 | 77N | 28W |
| N¼ COR | 26 | 77N | 28W |