Document 2006 5162

Book 2006 Page 5162 Type 06 043 Pages 1
Date 12/12/2006 Time 2:25 PM
Rec Amt $7.00

COMPUTER ✓
RECORDED ✓
COMPARED

MICHELLE UTSLER. COUNTY RECORDER
MADISON IOWA

RETURN TO : BOLDMAN LAND SURVEYING, P.C., BOX 66, WINTERSET,IA 50273 515-462-9242

# UNITED STATES PUBLIC LAND SURVEY CORNER CERTIFICATE

Land Survey Monuments situated In Section 11 OF, Township 77, Range 27, of the Fifth Principal Meridian, Madison County, Iowa
Previously recorded In Book 1 Page 103 In County Recorder's Office.
(book, page, document number, etc.)


(show reason for preparing this certificate, the evidence and detailed procedures used in establishing the corner positions and monumentation found or placed.)

Monument Description and Remarks: No certificates found

All tied to pk nail and orange washer (N+W) unless noted otherwise

PLAN-VIEW

(Show a minimum of three reference ties to durable physical objects, relevant monuments and physical conditions that will enable recovery of the corner.)

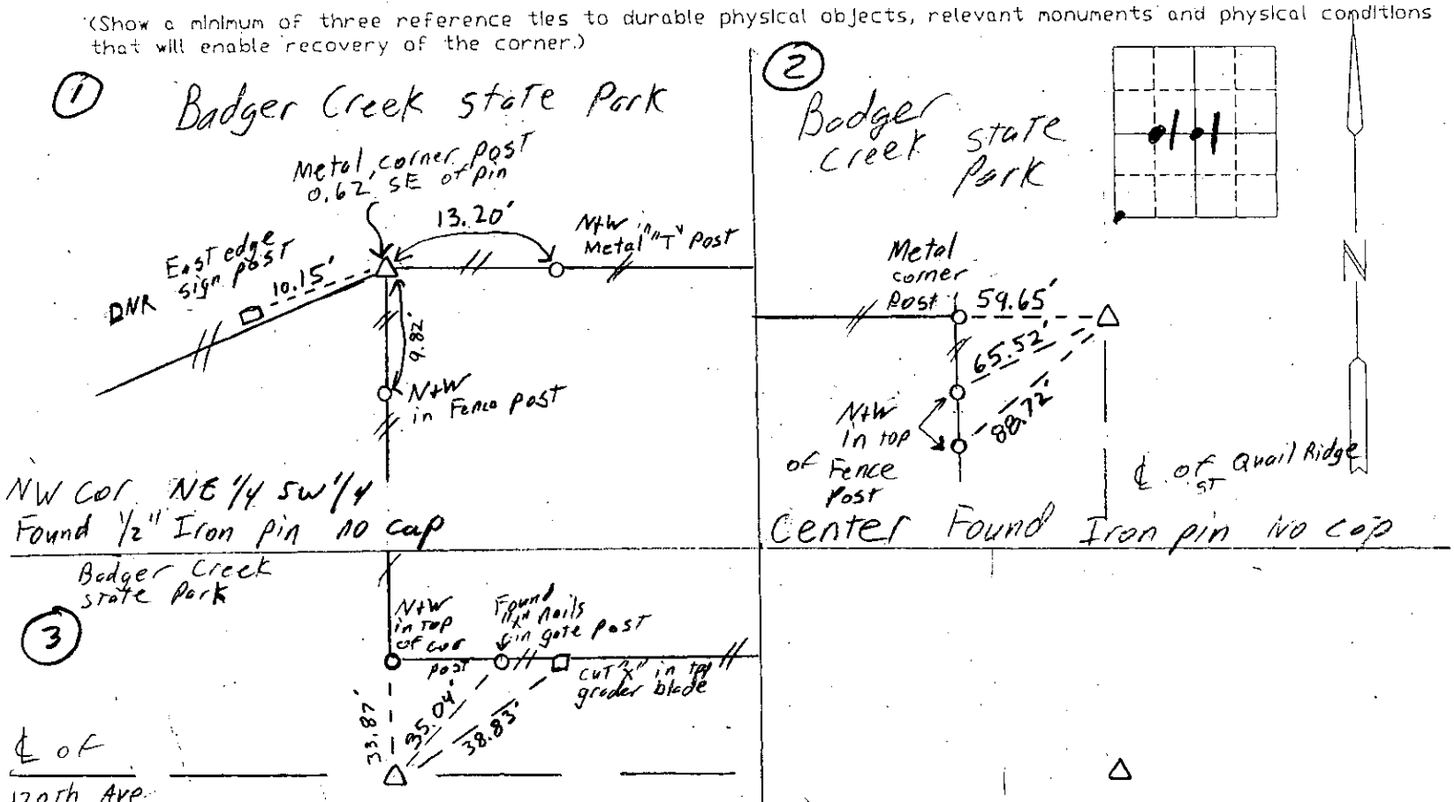


I hereby certify that the survey work was completed and this certificate was prepared by me or under my direct personal supervision and that I am a duly Licensed Land Surveyor under the laws of the State of Iowa.

Signature: Craig S. Boldman

Craig S. Boldman

Date: 12/11/06 Reg. No. 13427

SEAL

LICENSED LAND SURVEYOR
CRAIG S. BOLDMAN
13427
IOWA

List Corners to be Indexed

| Corners | Section | Twp | Range |
|---|---|---|---|
| SW | 11 | 77 | 27 |
| Center | 11 | 77 | 27 |
| NW cor E1/2 SW1/4 | 11 | 77 | 27 |

Project: 06080