Document 2006 4762

Book 2006 Page 4762 Type 06 043 Pages 1
Date 11/15/2006 Time 3:38 PM
Rec Amt $7.00

COMPUTER ✓
RECORDED ✓
COMPARED

MICHELLE UTSLER. COUNTY RECORDER
MADISON IOWA

VANCE & HOCHSTETLER, P.C., CONSULTING ENGINEERS, WINTERSET, IOWA (515) 462-3995
05-37s CHARLES T. VANCE, 110 West Green St., Winterset, Iowa, 50273
JAMES M HOCHSTETLER, 110 West Green St., Winterset, Iowa 50273

UNITED STATES PUBLIC LAND SURVEY CORNER CERTIFICATE

OF

Land Survey Monuments situated in Section 15, Township 76, Range 28 W, of the Fifth Principal Meridian, MADISON County, Iowa.
Previously recorded in _____ in County Recorder's Office.
(book, page, document number, etc.)


(Show reason for preparing this certificate, the evidence and detailed procedures used in establishing the the corner positions and monumentation found or placed.)

Monument Description and Remarks: NW COR SE¼ SE¼ - Set yellow CIR #6808 in fence line at prorated distance between SW Cor SE¼ SE¼ & Old Property fence corner at North line of 5 3¾ Acres of West 18¾ Acres of NE¼ SE¼. SW Cor. SE¼ SE¼ - Set yellow CIR #6808 at mid point on line between found SE Cor & S¼ Cor.

NE Cor SE¼ SE¼ - Set yellow CIR #6808 at mid point on line between found SE Cor & E¼ Cor.

PLAN - VIEW

(Show a minimum of three reference ties to durable physical objects, relevant monuments and physical conditions that will enable recovery of the corner.)

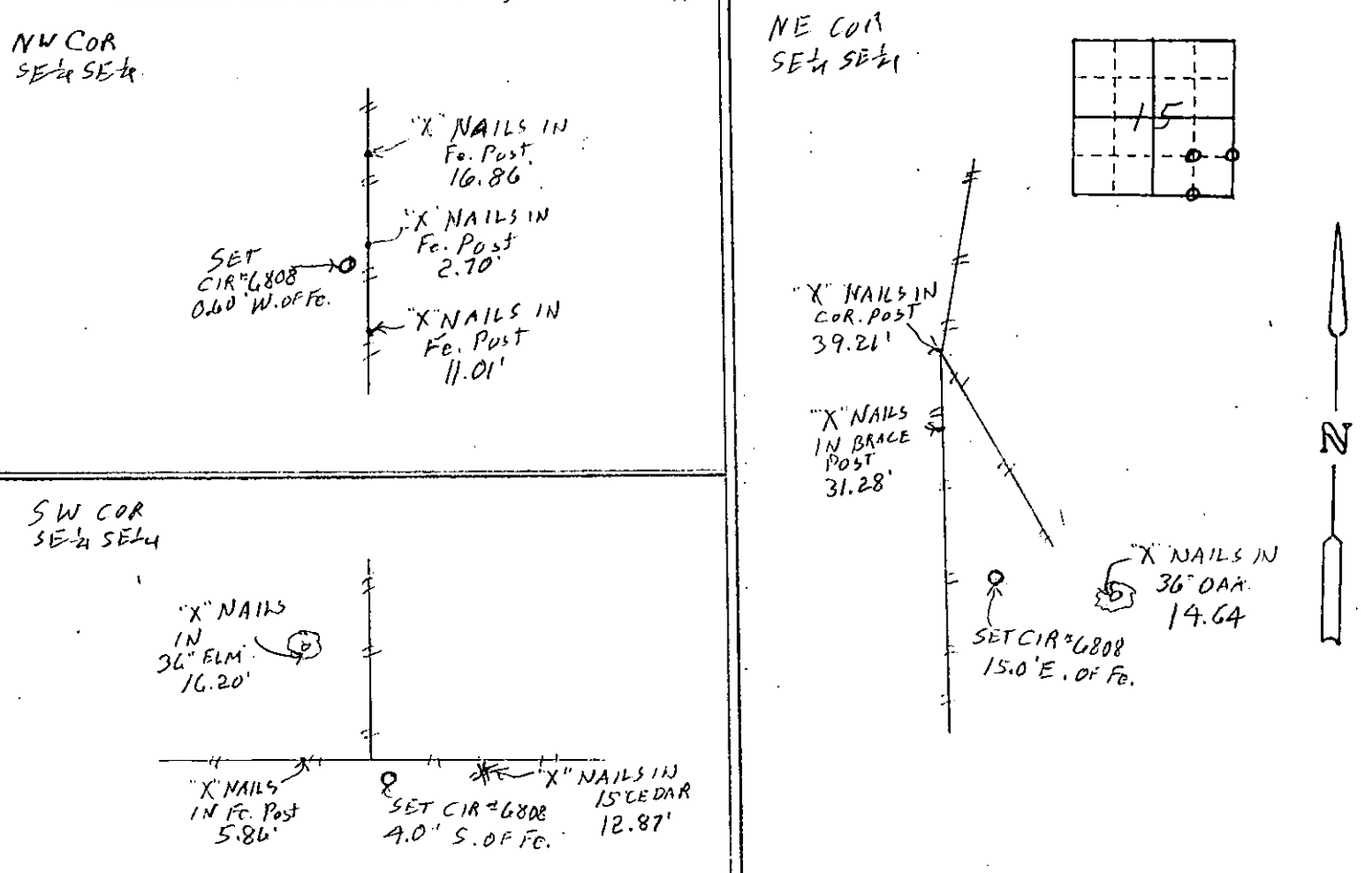

LICENSED LAND SURVEYOR
J. M. HOCHSTETLER #6808
IOWA

I hereby certify that this land surveying document was prepared and the related survey work was performed by me or under my direct personal supervision and that I am a duly licensed Land Surveyor under the laws of the State of Iowa.

J.M. HOCHSTETLER
License number 6808 Date 11/15/06.
My license renewal date is December 31, 2007
Pages or sheets covered by this seal: 1

List Corners to be Indexed

Corners	Section	Twp	Range
NW COR SE¼ SE¼	15	76	28
SW COR SE¼ SE¼	15	76	28
NE COR SE¼ SE¼	15	76	28