Document 2006 5184

Book 2006 Page 5184 Type 06 043 Pages 1
Date 12/14/2006 Time 12:42 PM
Rec Amt $7.00

COMPUTER ✓
RECORDED ✓
COMPARED

MICHELLE UTSLER. COUNTY RECORDER
MADISON IOWA

RETURN TO : BOLDMAN LAND SURVEYING, P.C., BOX 66, WINTERSET,IA 50273 515-462-9242

UNITED STATES PUBLIC LAND SURVEY CORNER CERTIFICATE

OF

Land Survey Monuments situated in Section 11, Township 77, Range 27, of the Fifth Principal Meridian, Madison County, Iowa
Previously recorded in Book 1 Page 103 In County Recorder's Office.
(book, page, document number, etc.)


(show reason for preparing this certificate, the evidence and detailed procedures used in establishing the corner positions and monumentation found or placed.)

Monument Description and Remarks: No certificates found

All tied to PK nail and orange washer (NAW) unless noted otherwise

PLAN-VIEW

(Show a minimum of three reference ties to durable physical objects, relevant monuments and physical conditions that will enable recovery of the corner.)

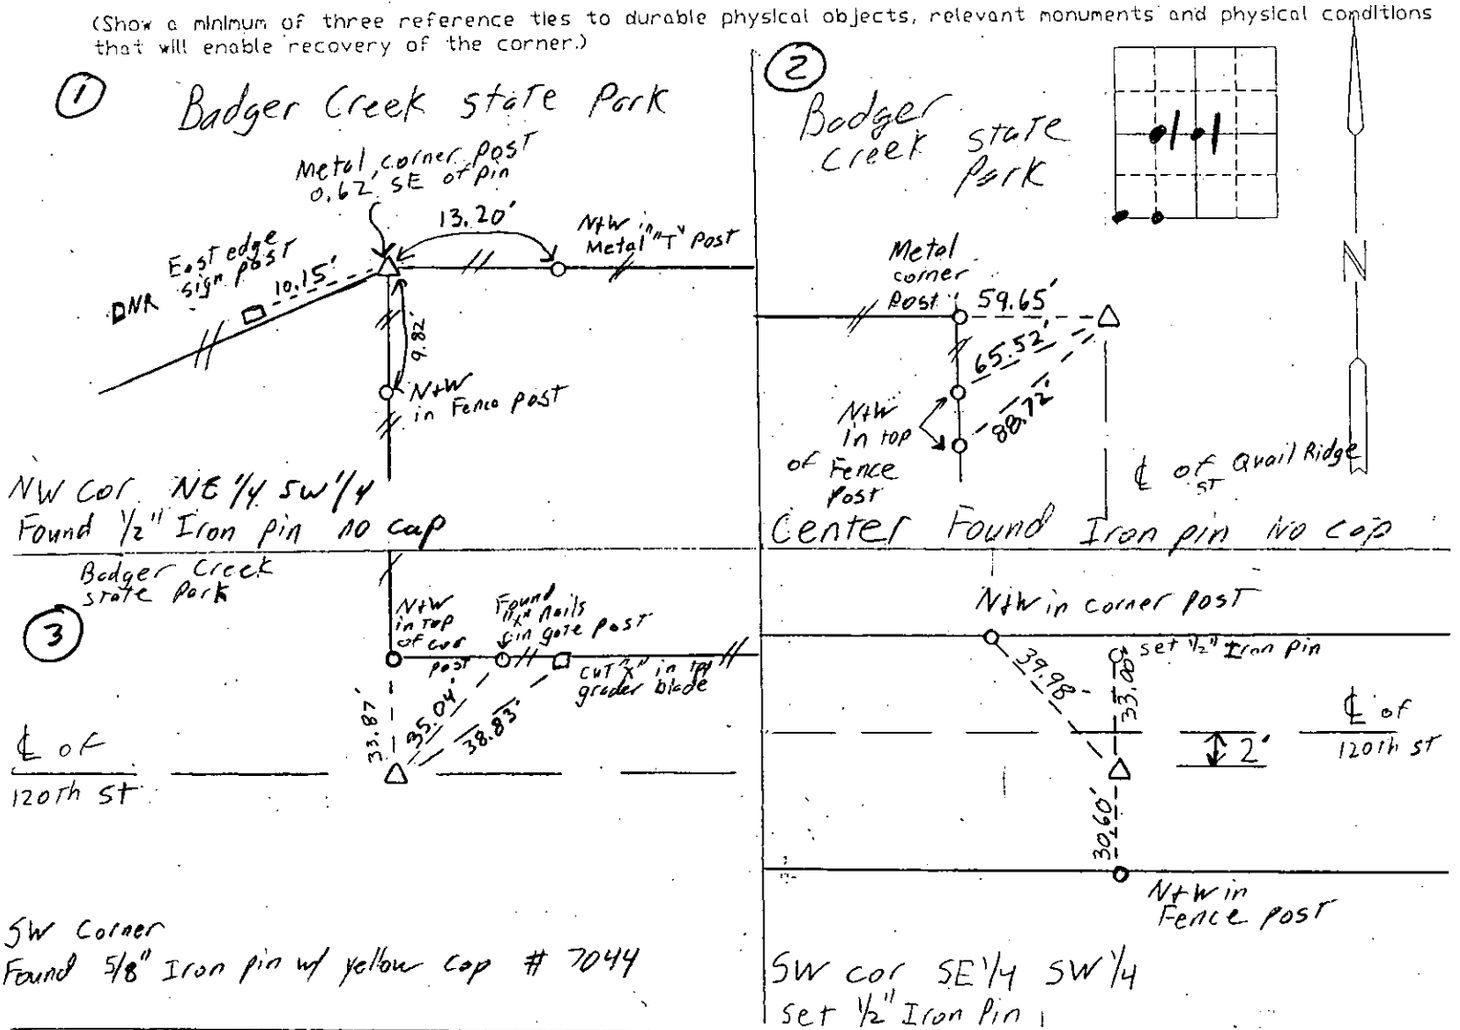

I hereby certify that the survey work was completed and this certificate was prepared by me or under my direct personal supervision and that I am a duly Licensed Land Surveyor under the laws of the State of Iowa

Signature: _____
Craig S. Boldman

Date: 12/6/06 Reg. No. 13427

SEAL

LICENSED LAND SURVEYOR
CRAIG S. BOLDMAN
13427
exp 12/31/06
IOWA

List Corners to be Indexed

Corners	Section	Twp	Range
SW	11	77	27
Center	11	77	27
NW cor NE¼ SW¼	11	77	27
SW cor SE¼ SW¼	11	77	27

Project: 06080