
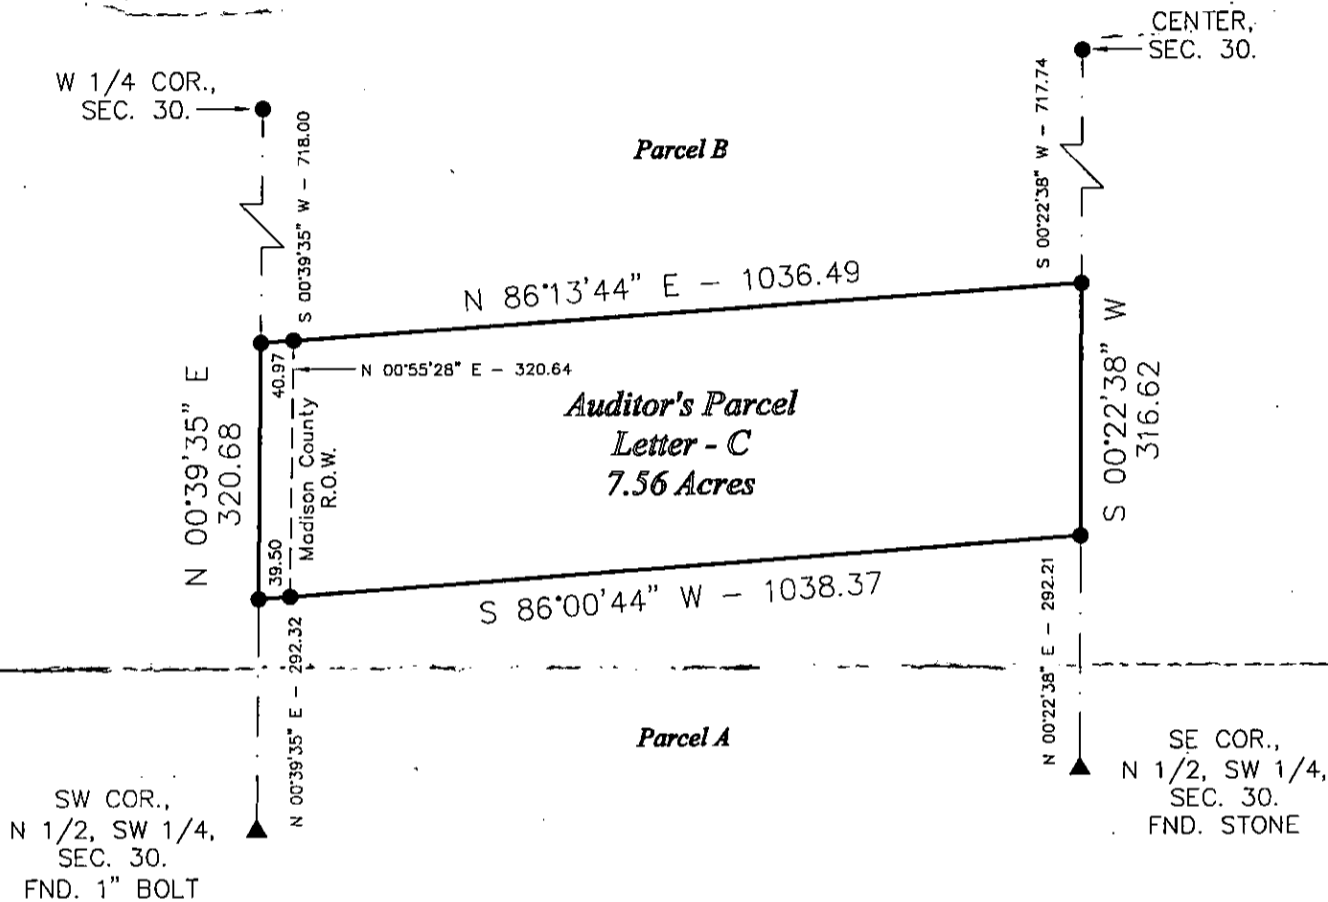


COMPUTED
RECORDED
COMPARED

MICHELLE UTSLER, COUNTY RECORDER
MADISON IOWA

MORRISSEY SURVEYING, 1405 HWY. G 28, OTLEY, IOWA 50214-8518, 641-627-5554

PLAT OF SURVEY
SW 1/4, SEC. 30, T-75N, R-26W
MADISON COUNTY, IOWA

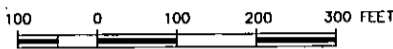

DESCRIPTION PARCEL - C

That part of the Southwest Quarter of Section 30, Township 75 North, Range 26 West of the Fifth Principal Meridian, Madison County, Iowa, described as follows:

Commencing at the West Quarter corner of said Section 30;
thence on an assumed bearing of South 00 degrees 39 minutes 35 seconds West 718.00 feet along the west line of the North 1/2 of the Southwest Quarter of said Section 30 to the point of beginning;
thence North 86 degrees 13 minutes 44 seconds East 1036.49 feet to the east line of the North 1/2 of said Southwest Quarter;
thence South 00 degrees 22 minutes 38 seconds West 316.62 feet along said east line;
thence South 86 degrees 00 minutes 44 seconds West 1038.37 feet to the west line of the North 1/2 of the Southwest Quarter of said Section 30;
thence North 00 degrees 39 minutes 35 seconds East 320.68 feet along said west line to the point of beginning.

Said tract contains 7.56 acres and is subject to Madison County Highway Easement over the westerly 0.30 acres thereof.

MONUMENTS

- ▲ - found sec. cor. (pipe, stone, etc.)
- - set - 5/8" x 18" rebar with orange plastic cap P.L.S. 7995
- - no monument found or set
- - found lot cor. (pipe, stone, etc.)



I hereby certify that this land surveying document was prepared and the related survey work was performed by me or under my direct personal supervision and that I am a duly Licensed Land Surveyor under the laws of the State of Iowa.

Signed *J. Brian Morrissey* Date 12/13/06
J. Brian Morrissey Iowa Lic. No. 7995
My license renewal date is 12/31/2007.
Pages covered by this seal: 1

SURVEY FOR AND OWNER: RICHARD & KATHLEENA DICKINSON, ST. CHARLES, IA 50240