Document 2007 258

Book 2007 Page 258 Type 06 043 Pages 1
Date 1/19/2007 Time 11:00 AM
Rec Amt $7.00

INDX ✓
ANNO
SCAN

LISA SMITH. COUNTY RECORDER
MADISON IOWA

CHEK

Prepared By: J. Brian Morrissey, Morrissey Surveying, 1405 Hwy. G28, Otley, Ia. 50214, Tel. (641) 627-5554

UNITED STATES PUBLIC LAND SURVEY CORNER CERTIFICATE OF

Land Survey Monuments situated in Section 30, Township 75N, Range 26W, of the Fifth Principal Meridian, Madison County,Iowa.
Previously recorded in N.A. in County Recorders Office.


(book, page, document number,etc.)


(Show reason for preparing this certificate, the evidence and detailed procedures used in establishing the corner positions and monumentation found or placed.)

Monument Description and Remarks: Found 4"x6"x10" limestone at fence corner, accepted position. Set 5/8"x18" orange plastic capped rebar, #7995 on west side of limestone.

PLAN VIEW

(Show a minimum of three reference ties to durable physical objects, relevant monuments and physical conditions that will enable recovery of the corner.)

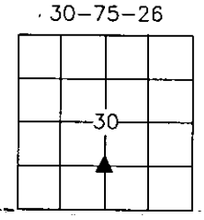

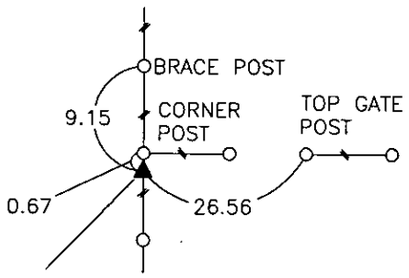



FOUND 4"x6"x10" LIMESTONE, 10" DEEP. SET 5/8"X18" ORANGE PLASRIC CAPPED REBAR, #7995 ON WEST SIDE OF STONE.

NW COR., SW 1/4, SE 1/4, SEC. 30

NOTE: ALL TIES TO "X" NAILS UNLESS NOTED.



I hereby certify that the survey work was completed and this certificate was prepared by me or under my direct personal supervision and that I am a duly Licensed Land Surveyor under the laws of the State of Iowa.

Signature: J. Brian Morrissey Date: 1/18/07
J. Brian Morrissey

License number 7995.
My license renewal date is December 31, 2007

542-06-1