Document 2007 536

Book 2007 Page 536 Type 06 043 Pages 1
Date 2/07/2007 Time 1:56 PM
Rec Amt $7.00

INDX✓
ANNO
SCAN

LISA SMITH. COUNTY RECORDER
MADISON IOWA

CHEK

VANCE & HOCHSTETLER, P.C., CONSULTING ENGINEERS, WINTERSET, IOWA (515) 462-3995
CHARLES T. VANCE, 110 West Green St., Winterset, Iowa, 50273
JAMES M HOCHSTETLER, 110 West Green St., Winterset, Iowa 50273

UNITED STATES PUBLIC LAND SURVEY CORNER CERTIFICATE

OF

Land Survey Monuments situated in Section 23, Township 75N, Range 27W, of the Fifth Principal Meridian, MADISON County, Iowa.
Previously recorded in _____ (book, page, document number, etc.) in County Recorder's Office.

(Show reason for preparing this certificate, the evidence and detailed procedures used in establishing the the corner positions and monumentation found or placed.)


Monument Description and Remarks: NW COR SE¼ NW¼ - Set yellow CIR #6808 exposed at intersection of N&S property line fence with property line fence from East.


SW Cor. SE¼ NE¼ - Set yellow CIR #6808 exposed at old existing property line fence corner.


SW Cor SE¼ NW¼ - Set yellow CIR #6808 exposed at intersection of E&W property line fence & Property line fence from North.

PLAN - VIEW

(Show a minimum of three reference ties to durable physical objects, relevant monuments and physical conditions that will enable recovery of the corner.)

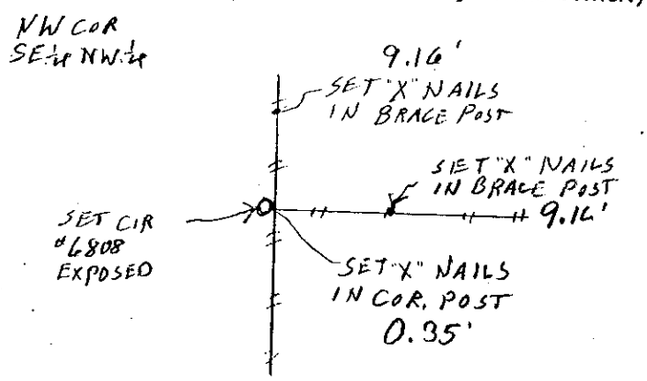

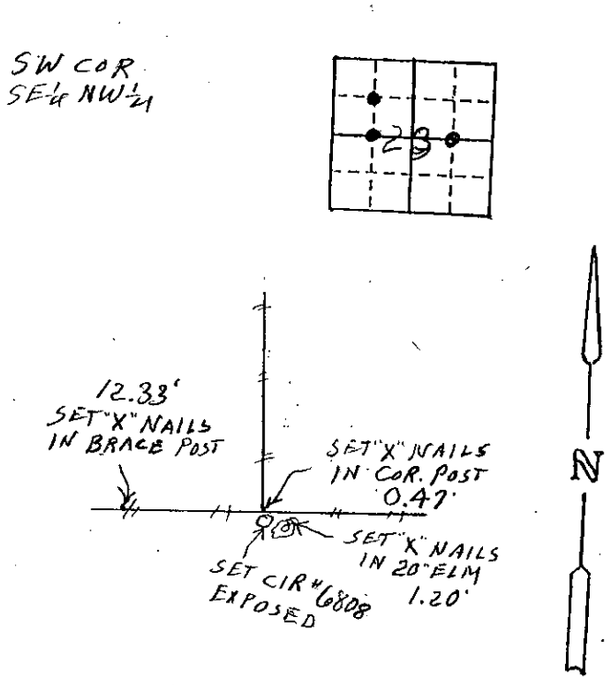

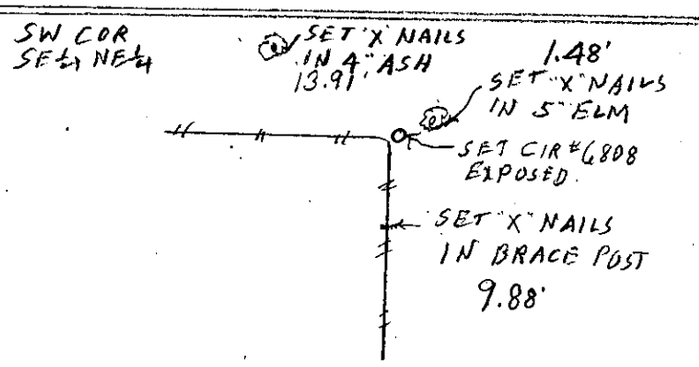

LICENSED LAND SURVEYOR
J. M.
HOCHSTETLER
#6808
IOWA

I hereby certify that this land surveying document was prepared and the related survey work was performed by me or under my direct personal supervision and that I am a duly licensed Land Surveyor under the laws of the State of Iowa.

J.M. HOCHSTETLER

License number 6808 Date 1/19/07

My license renewal date is December 31, 2007

Pages or sheets covered by this seal: 1

List Corners to be Indexed

Corners	Section	Twp	Range
NW COR SE¼ NW¼	23	75N	27W
SW COR SE¼ NE¼	23	75N	27W
SW COR SE¼ NW¼	23	75N	27W