Document 2007 712

Book 2007 Page 712 Type 06 043 Pages 1
Date 2/20/2007 Time 12:48 PM
Rec Amt $7.00

INDX Y
ANNO
SCAN

LISA SMITH. COUNTY RECORDER
MADISON IOWA

CHEK

VANCE & HOCHSTETLER, P.C., CONSULTING ENGINEERS, WINTERSET, IOWA (515) 462-3995
2005-905 CHARLES T. VANCE, 110 West Green St., Winterset, Iowa, 50273
JAMES M HOCHSTETLER, 110 West Green St., Winterset, Iowa 50273

UNITED STATES PUBLIC LAND SURVEY CORNER CERTIFICATE OF


Land Survey Monuments situated in Section 35, Township 74N, Range 29 W, of the Fifth Principal Meridian, MADISON County, Iowa.
Previously recorded in _____ in County Recorder's Office.
(book, page, document number, etc.)


(Show reason for preparing this certificate, the evidence and detailed procedures used in establishing the the corner positions and monumentation found or placed.)


Monument Description and Remarks: S.W.Cor. NW¼ SE¼ - found ½" Iron Rod at ℄ County Road in line with property line fence to South. SE Cor NW¼ SE¼ - Set yellow CIR #6808, 4" Deep at ℄ County Road in line with property line fence North. N.E.Cor NW¼ SE¼ - Set yellow CIR #6808 exposed at Three Way property line fence intersection.

PLAN - VIEW

(Show a minimum of three reference ties to durable physical objects, relevant monuments and physical conditions that will enable recovery of the corner.)

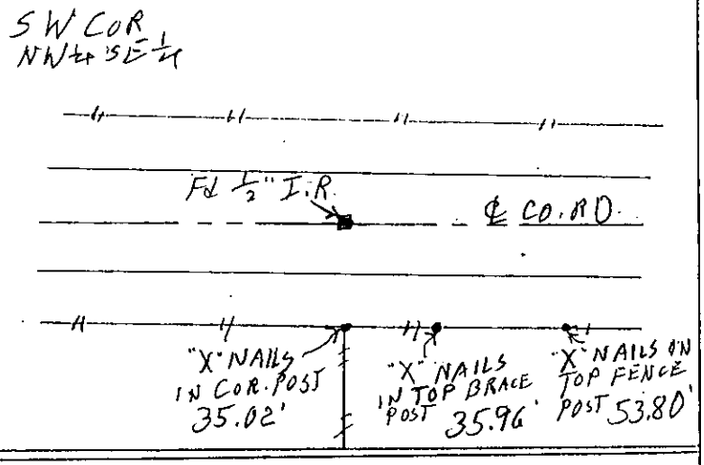

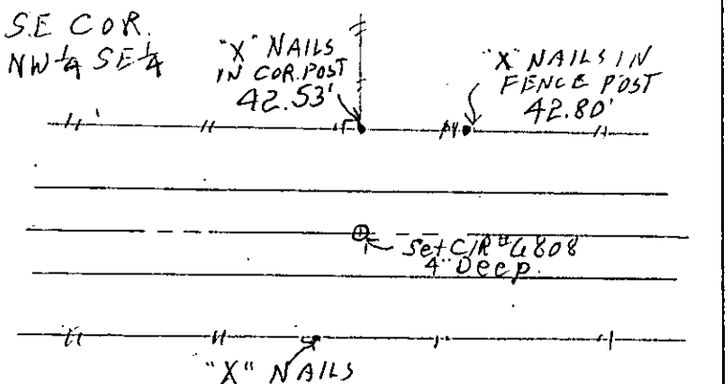

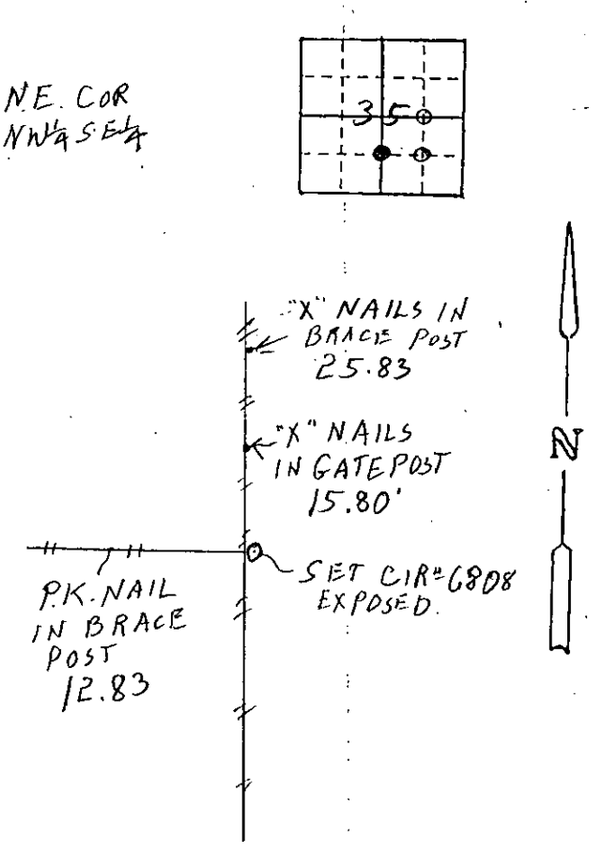

LICENSED LAND SURVEYOR
J. M. HOCHSTETLER #6808
IOWA

I hereby certify that this land surveying document was prepared and the related survey work was performed by me or under my direct personal supervision and that I am a duly licensed Land Surveyor under the laws of the State of Iowa.

J. M. Hochstetler
J.M. HOCHSTETLER
License number 6808 Date 2/9/07
My license renewal date is December 31, 2007
Pages or sheets covered by this seal: 1

List Corners to be Indexed

Corners	Section	Twp	Range
SW COR NW¼ SE¼	35	74N	29 W
SE COR NW¼ SE¼	35	74N	29 W
N.E. Cor. NW¼ SE¼	35	74N	29 W