Document 2007 713

Book 2007 Page 713 Type 06 043 Pages 1
Date 2/20/2007 Time 12:56 PM
Rec Amt $7.00

IND
ANN
SCA

LISA SMITH. COUNTY RECORDER
MADISON IOWA

CHE

RETURN TO : BOLDMAN LAND SURVEYING, P.C., BOX 66, WINTERSET,IA 50273 515-462-9242

UNITED STATES PUBLIC LAND SURVEY CORNER CERTIFICATE

OF

Land Survey Monuments situated in Section 4, Township 75, Range 26, of the Fifth Principal Meridian, Madison County, Iowa
Previously recorded in None recorded In County Recorder's Office.
(book, page, document number, etc.)


(show reason for preparing this certificate, the evidence and detailed procedures used in establishing the corner positions and monumentation found or placed.)


Monument Description and Remarks: As shown

All tied to pk nail and orange washer (N+W) unless noted otherwise


PLAN-VIEW

(Show a minimum of three reference ties to durable physical objects, relevant monuments and physical conditions that will enable recovery of the corner.)

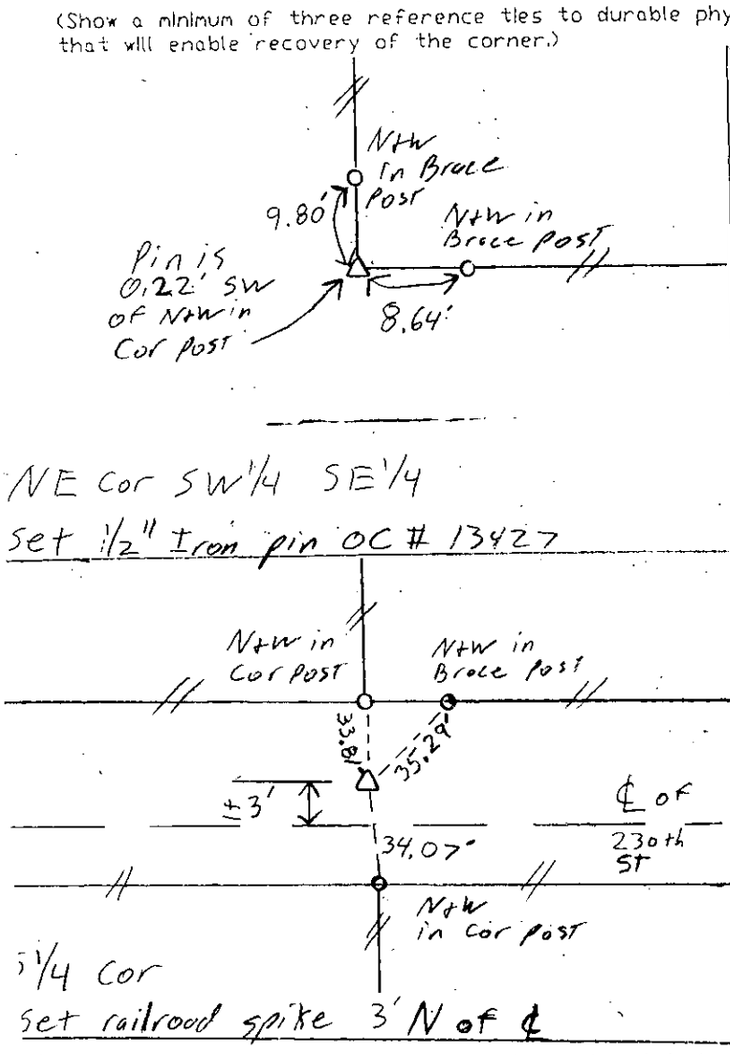

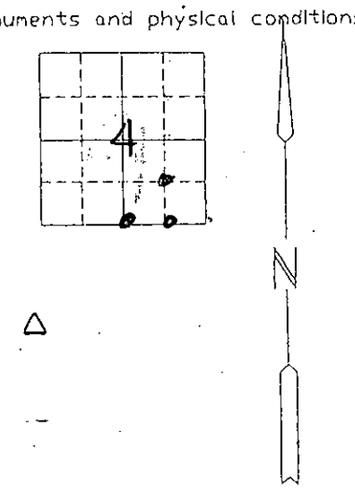

NE Cor SW1/4 SE1/4
set 1/2" Iron pin OC # 13427

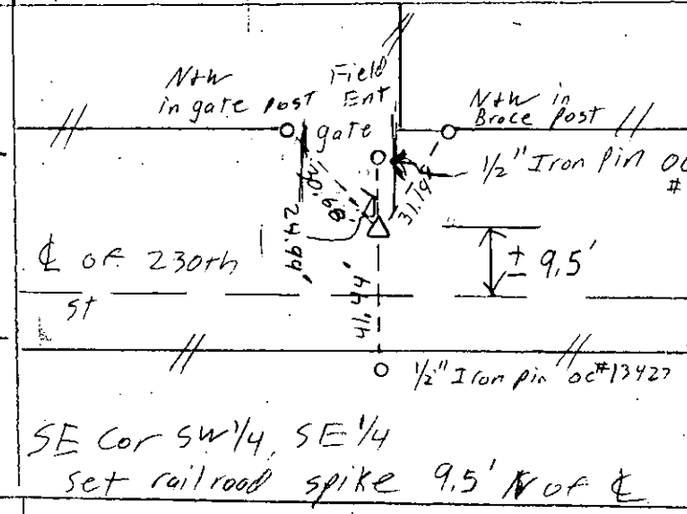

5 1/4 Cor
Set railroad spike 3' N of ℄

SE Cor SW1/4, SE1/4
set railroad spike 9.5' N of ℄

I hereby certify that the survey work was completed and this certificate was prepared by me or under my direct personal supervision and that I am a duly Licensed Land Surveyor under the laws of the State of Iowa

Signature: Craig S. Boldman

Date: 2/8/07 Reg. Num. 13427

SEAL

LICENSED LAND SU
exp
CRAIG S. BOLDMAN
13427
12/31/08
IOWA

List Corners to be Indexed

Corners	Section	Twp	Range
5 1/4 Cor	4	75	26
NE Cor SW1/4 SE1/4	4	75	26
SE Cor SW1/4 SE1/4	4	75	26

Project 07005