Document 2007 716

Book 2007 Page 716 Type 06 043 Pages 1
Date 2/20/2007 Time 12:58 PM
Rec Amt $7.00

INDX ✓
ANNO
SCAN
CHEK

LISA SMITH. COUNTY RECORDER
MADISON IOWA

RETURN TO : BOLDMAN LAND SURVEYING, P.C., BOX 66, WINTERSET,IA 50273 515-462-9242

# UNITED STATES PUBLIC LAND SURVEY CORNER CERTIFICATE

OF

Land Survey Monuments situated in Section 9, Township 74, Range 27, of the Fifth Principal Meridian, Madison County, Iowa
Previously recorded in None Recorded In County Recorder's Office.
(book, page, document number, etc.)


(show reason for preparing this certificate, the evidence and detailed procedures used in establishing the corner positions and monumentation found or placed.)

Monument Description and Remarks: As noted


All tied to pk nail and orange washer (N+W) unless noted otherwise


PLAN-VIEW

(Show a minimum of three reference ties to durable physical objects, relevant monuments and physical conditions that will enable recovery of the corner.)

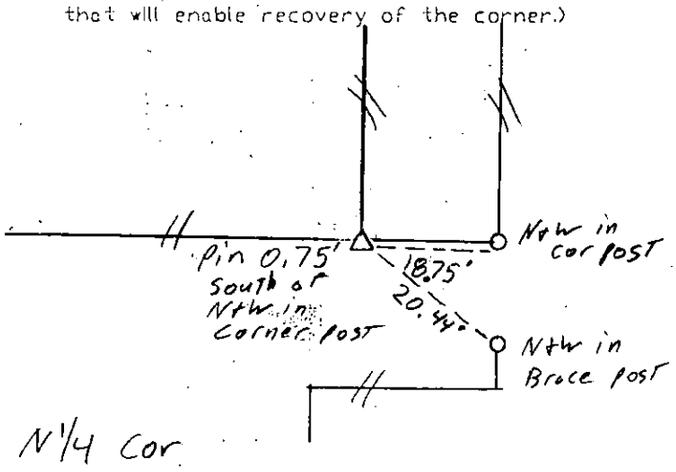



N 1/4 Cor
Set 1/2" Iron pin oc # 13427

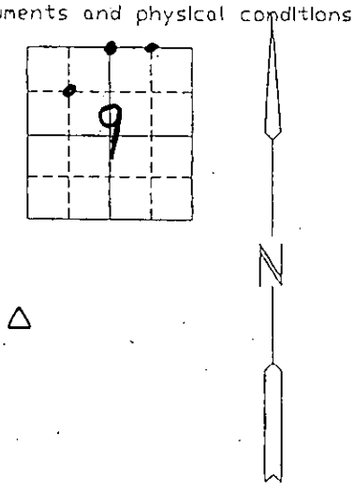

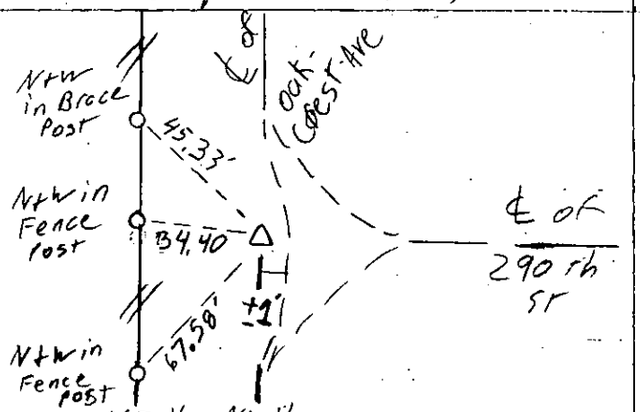
SW corner NE 1/4, NW 1/4
Found iron pin

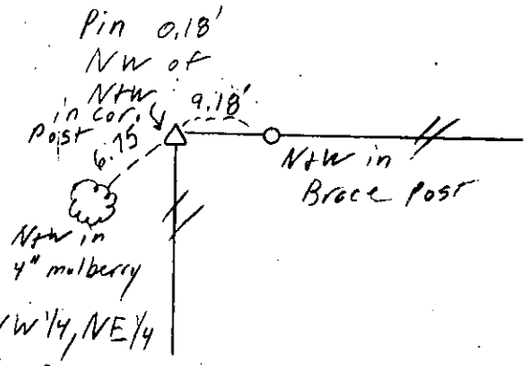


NE Cor, NW 1/4, NE 1/4
Set 1/2" Iron Pin oc # 13427

I hereby certify that the survey work was completed and this certificate was prepared by me or under my direct personal supervision and that I am a duly licensed Land Surveyor under the laws of the State of Iowa

Signature: Craig S. Boldman

Craig S. Boldman

Date: 2/8/07 Reg. No. 13427

SEAL

LICENSED LAND SURVEYOR
CRAIG S. BOLDMAN
13427
IOWA

List Corners to be Indexed

| Corners | Section | Twp | Range |
|---|---|---|---|
| N 1/4 | 9 | 74 | 27 |
| NE Cor NW 1/4, NE 1/4 | 9 | 74 | 27 |
| SW cor NE 1/4, NW 1/4 | 9 | 74 | 27 |

Project 07004