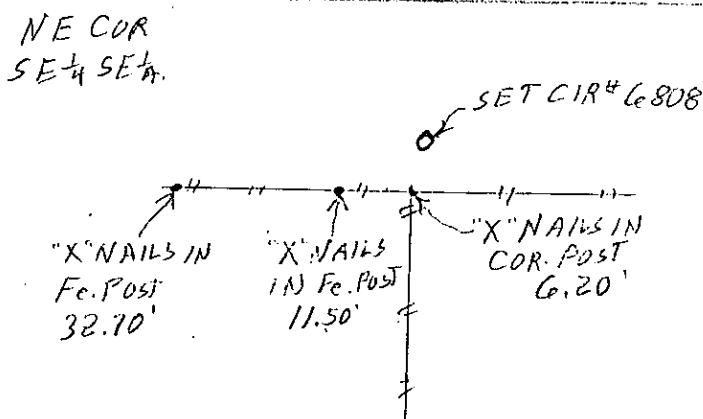
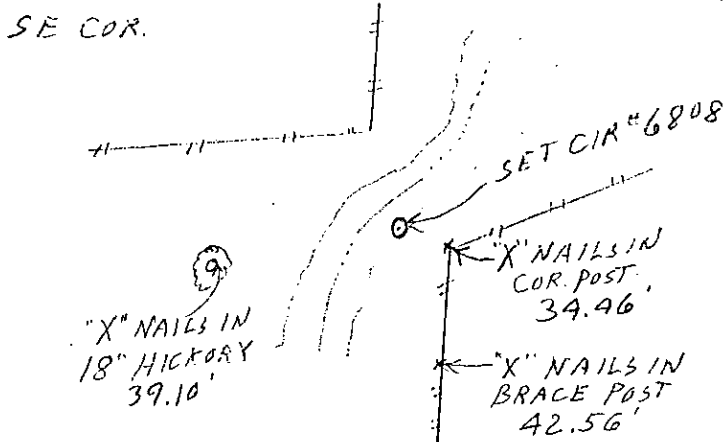
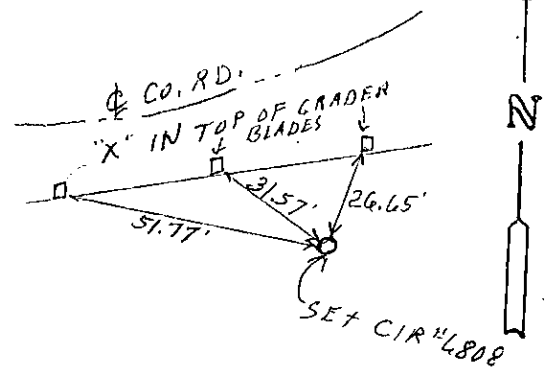
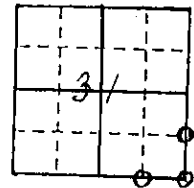


LISA SMITH, COUNTY RECORDER
MADISON IOWAVANCE & HOCHSTETLER, P.C., CONSULTING ENGINEERS, WINTERSSET, IOWA (515) 462-3995
CHARLES T. VANCE, 110 West Green St., Winterset, Iowa, 50273
JAMES M HOCHSTETLER, 110 West Green St., Winterset, Iowa 50273UNITED STATES PUBLIC LAND SURVEY CORNER CERTIFICATE
OFLand Survey Monuments situated in Section 31, Township 76 N., Range 29 W., of the Fifth Principal Meridian, MADISON County, Iowa.
Previously recorded in _____ in County Recorder's Office.
(book, page, document number, etc.)

(Show reason for preparing this certificate, the evidence and detailed procedures used in establishing the the corner positions and monumentation found or placed.)


Monument Description and Remarks: SE COR - Set yellow CIR #6808 exposed based on found S $\frac{1}{4}$ Cor. and set SW Cor SE $\frac{1}{4}$ SE $\frac{1}{4}$ and dimensions shown in old County Engineer's field notes. NE Cor. SE $\frac{1}{4}$ SE $\frac{1}{4}$ - Set yellow CIR #6808 in line with N. & S. fence line and parallel to S. line SE $\frac{1}{4}$ of Section. SW Cor. SE $\frac{1}{4}$ SE $\frac{1}{4}$ - Set yellow CIR #6808 exposed from ties filed by Morrissey in Section Corner Book 1, Page 380 (Rural Water Contractor dug out existing stone and 3" Iron rod)
PLAN - VIEW

(Show a minimum of three reference ties to durable physical objects, relevant monuments and physical conditions that will enable recovery of the corner.)

SW COR
NE $\frac{1}{4}$ NE $\frac{1}{4}$ 

List Corners to be Indexed

Corners	Section	Twp	Range
SE COR	31	76 N	29 W
NE COR SE $\frac{1}{4}$ SE $\frac{1}{4}$	31	76 N	29 W
SW COR SE $\frac{1}{4}$ SE $\frac{1}{4}$	31	76 N	29 W

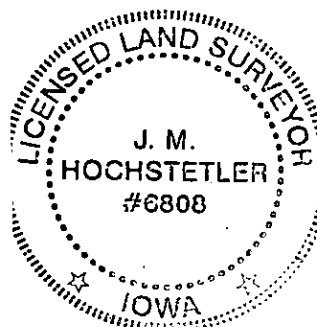

I hereby certify that this land surveying document was prepared and the related survey work was performed by me or under my direct personal supervision and that I am a duly licensed Land Surveyor under the laws of the State of Iowa.

J. M. HOCHSTETLER

License number 6808 Date 2/8/07

My license renewal date is December 31, 2007

Pages or sheets covered by this seal: 1