Document 2007 1890
Book 2007 Page 1890 Type 06 043 Pages 1
Date 5/04/2007 Time 10:05 AM
Rec Amt $7.00

INDX ✓
ANNC
SCAN
CHEK

LISA SMITH. COUNTY RECORDER
MADISON IOWA

VANCE & HOCHSTETLER, P.C., CONSULTING ENGINEERS, WINTERSET, IOWA (515) 462-3995
CHARLES T. VANCE, 110 West Green St., Winterset, Iowa, 50273
JAMES M HOCHSTETLER, 110 West Green St., Winterset, Iowa 50273

07-325

UNITED STATES PUBLIC LAND SURVEY CORNER CERTIFICATE OF

Land Survey Monuments situated in Section 18, Township 76 N, Range 27 W, of the Fifth Principal Meridian, MADISON County, Iowa.
Previously recorded in _____ in County Recorder's Office.
(book, page, document number, etc.)


(Show reason for preparing this certificate, the evidence and detailed procedures used in establishing the the corner positions and monumentation found or placed.)

Monument Description and Remarks: NE COR NW¼ NE¼ - Set yellow CIR #6808 exposed at midpoint on line between found N¼ Cor & NE Cor. NW Cor SW¼ NE¼ - Set yellow CIR #6808 at midpoint on line between found Center and N¼ Cor.


PLAN - VIEW


(Show a minimum of three reference ties to durable physical objects, relevant monuments and physical conditions that will enable recovery of the corner.)

NE COR
NW¼ NE¼

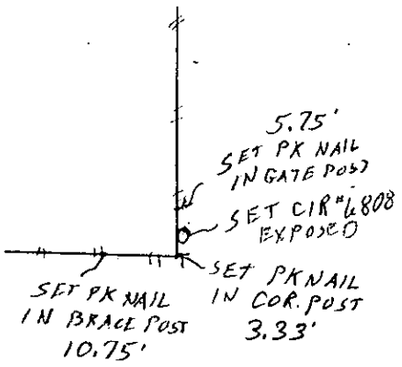

NW COR
SW¼ NE¼

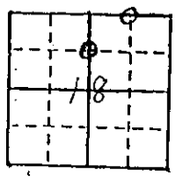

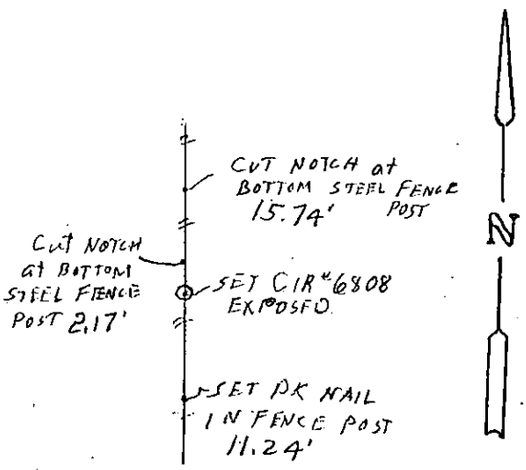

LICENSED LAND SURVEYOR
J. M. HOCHSTETLER
#6808
IOWA

I hereby certify that this land surveying document was prepared and the related survey work was performed by me or under my direct personal supervision and that I am a duly licensed Land Surveyor under the laws of the State of Iowa.

J.M. HOCHSTETLER
License number 6808 Date 4/2 7/07
My license renewal date is December 31, 2007
Pages or sheets covered by this seal: 1

List Corners to be Indexed

Corners	Section	Twp	Range
NE COR NW¼ NE¼	18	76N	27W
NW COR SW¼ NE¼	18	76N	27W