Document 2007 1891

Book 2007 Page 1891 Type 06 043 Pages 1
Date 5/04/2007 Time 10:05 AM
Rec Amt $7.00

IND ✓
ANNC
SCAN

LISA SMITH, COUNTY RECORDER
MADISON IOWA

CHEK

VANCE & HOCHSTETLER, P.C., CONSULTING ENGINEERS, WINTERSET, IOWA (515) 462-3995
CHARLES T. VANCE, 110 West Green St., Winterset, Iowa, 50273
JAMES M HOCHSTETLER, 110 West Green St., Winterset, Iowa 50273

07-325

UNITED STATES PUBLIC LAND SURVEY CORNER CERTIFICATE

OF


Land Survey Monuments situated in Section 8, Township 76N, Range 27W, of the Fifth Principal Meridian, MADISON County, Iowa.
Previously recorded in _____ in County Recorder's Office.
(book, page, document number, etc.)

(Show reason for preparing this certificate, the evidence and detailed procedures used in establishing the the corner positions and monumentation found or placed.)

Monument Description and Remarks: NW COR SW¼ SW¼ - Set yellow CIR #6808 at Midpoint on line between found SW COR & W¼ Cor.
NE COR NW¼ SE¼ - Set yellow CIR #6808 Exposed - Set yellow CIR #6808 on line between found SE Cor. SW¼ SE¼ & Old property fence corner at NE Cor S½ SW¼ NE¼. Prorated distance to set NE Cor NW¼ SE¼ & NE COR SW¼ SE¼.
S¼ Cor: Set yellow CIR #6808 exposed at at old estab. property line fence Corner.

PLAN - VIEW

(Show a minimum of three reference ties to durable physical objects, relevant monuments and physical conditions that will enable recovery of the corner.)

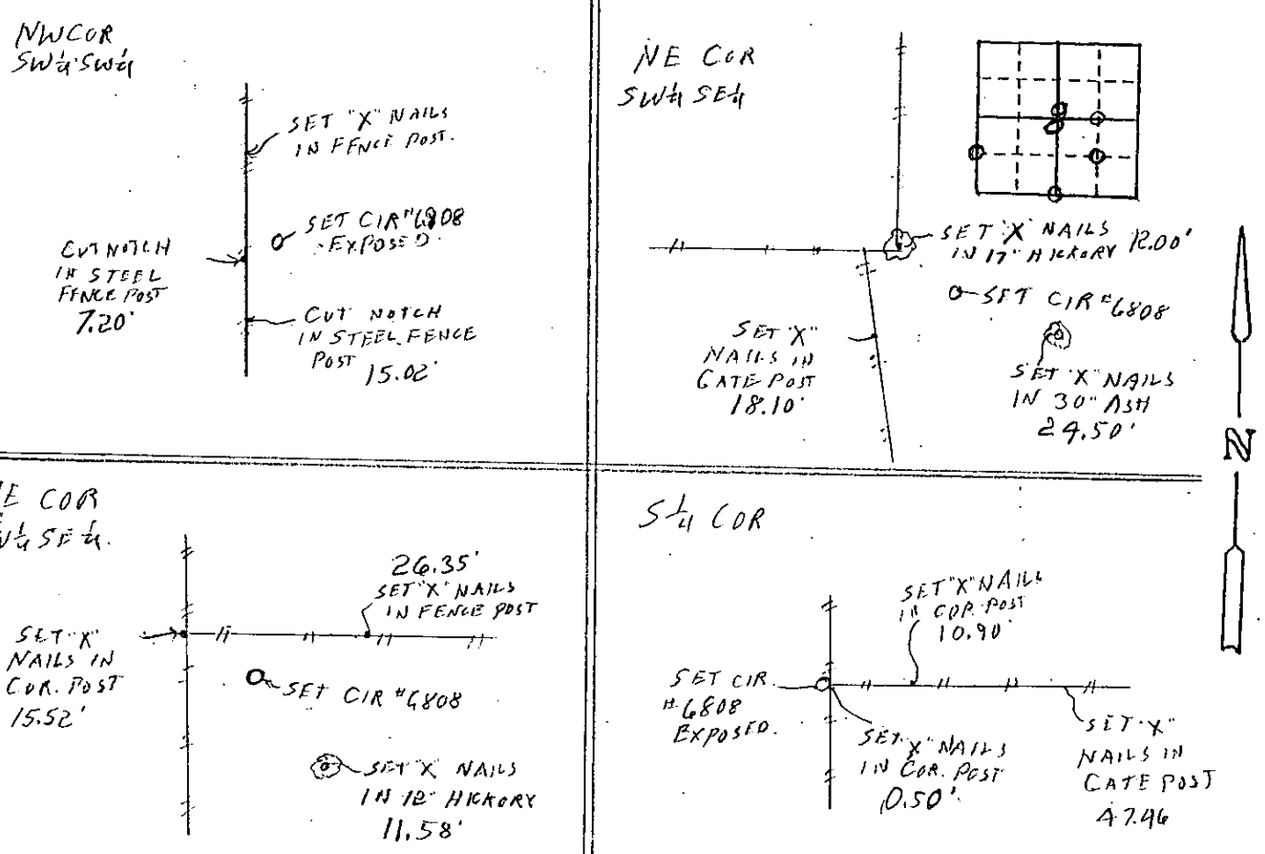

LICENSED LAND SURVEYOR
J. M. HOCHSTETLER
#6808
IOWA

I hereby certify that this land surveying document was prepared and the related survey work was performed by me or under my direct personal supervision and that I am a duly licensed Land Surveyor under the laws of the State of Iowa.

J.M. HOCHSTETLER
License number 6808 Date 4/27/07.
My license renewal date is December 31, 2007
Pages or sheets covered by this seal: 1

List Corners to be Indexed

Corners	Section	Twp	Range
NW COR SW¼ SW¼	8	76N	27W
NE COR NW¼ SE¼	8	76N	27W
NE COR SW¼ SE¼	8	76N	27W
S¼ COR	8	76N	27W