Document 2007 1567

Book 2007 Page 1567 Type 06 043 Pages 1
Date 4/17/2007 Time 10:37 AM
Rec Amt $7.00

IND ✓
ANN
SCAN

LISA SMITH. COUNTY RECORDER
MADISON IOWA

CHEK

RETURN TO : BOLDMAN LAND SURVEYING, P.C., BOX 66, WINTERSET,IA 50273 515-462-9242

UNITED STATES PUBLIC LAND SURVEY CORNER CERTIFICATE

OF


Land Survey Monuments situated in Section 6, Township 75 N, Range 29W, of the Fifth Principal Meridian, Madison County, Iowa
Previously recorded in None In County Recorder's Office.
(book, page, document number, etc.)


(show reason for preparing this certificate, the evidence and detailed procedures used in establishing the corner positions and monumentation found or placed.)

Monument Description and Remarks: Set on E-W extension from SW cor. and S 1/4 cor. Looked for SE cor not found. Used N-S extension of fence line North. All tied to pk nail and orange washer (New) unless noted otherwise

PLAN-VIEW

(Show a minimum of three reference ties to durable physical objects, relevant monuments and physical conditions that will enable recovery of the corner.)

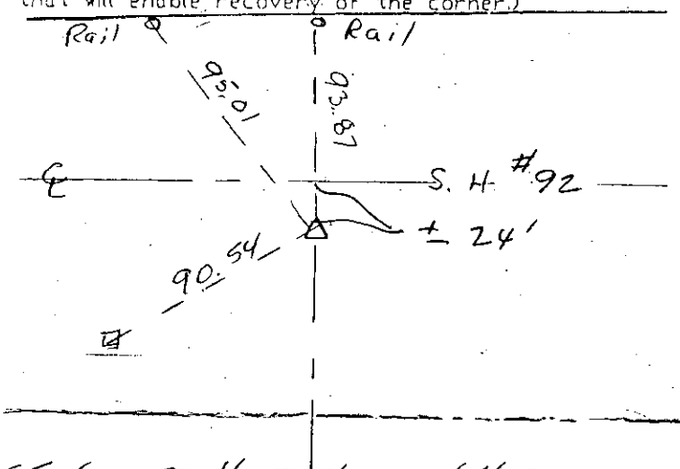

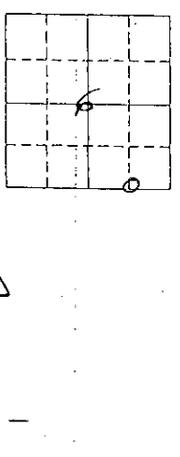

SE Cor, SW1/4 SE1/4 - set 1/2" pin LS 13427

I hereby certify that the survey work was completed and this certificate was prepared by me or under my direct personal supervision and that I am a duly Licensed Land Surveyor under the laws of the State of Iowa

Signature: Craig S. Boldman

Date: 9/15/07 Reg. No. 13427

SEAL

LICENSED LAND SURVEYOR
CRAIG S. BOLDMAN
13427
12/31/08
IOWA

List Corners to be Indexed

Corners	Section	Twp	Range
SE Cor SW1/4 SE1/4	6	75	29

Job # 07021