Document 2007 2202

Book 2007 Page 2202 Type 06 043 Pages 1
Date 5/29/2007 Time 3:57 PM
Rec Amt $7.00

INDX
ANNC
SCAN

LISA SMITH, COUNTY RECORDER
MADISON IOWA

CHEK

VANCE & HOCHSTETLER,P.C. CONSULTING ENGINEERS, WINTERSET, IOWA (515)462-3995
07-265 CHARLES T. VANCE, 110 WEST GREEN ST.,WINTERSET, IOWA 50273
JAMES M. HOCHSTETLER, 110 WEST GREEN ST., WINTERSET, IOWA 50273

UNITED STATES PUBLIC LAND SURVEY CORNER CERTIFICATE

OF

Land Survey Monuments situated in Section 30, Township 76 North, Range 27 West, of the Fifth Principal Meridian, Madison County, Iowa.
Previously recorded in N/A (book, page, document number, etc.) in County Recorder's Office.


(Show reason for preparing this certificate, the evidence and detailed procedures used in establishing the corner positions and monumentation found or placed.)

Monument Description and Remarks: Found 1" dia. Iron Rod at the North Quarter of Section 30, T76N, R27W.


Reset Capped Iron Rod #5041 at the Southwest Corner of NE.¼ SW.¼ of Section 30, T76N, R27W using data from previous surveys.

PLAN - VIEW

(Show a minimum of three reference ties to durable physical objects, relevant monuments and physical conditions that will enable recovery of the corner.)

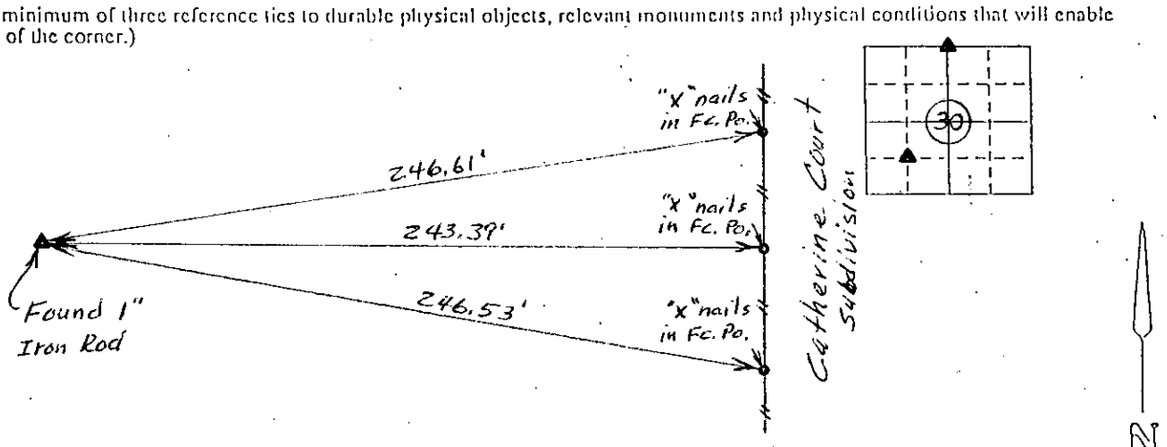

Ref. to N.¼ Cor. Section 30, T76N, R27W

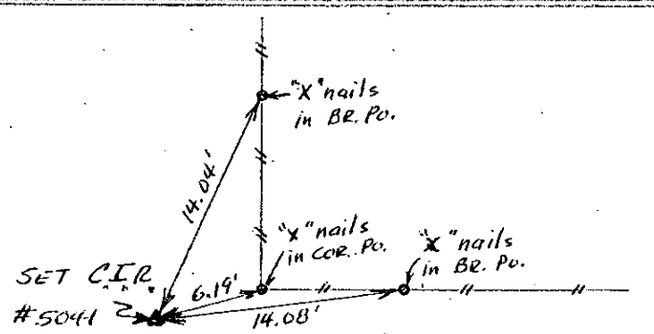

Ref. to SW. Cor. NE.¼ SW.¼ Section 30, T76N, R27W.

I hereby certify that this land surveying document was prepared and the related survey work was preformed by me or under my direct personal supervision and that I am a duly Licensed Land Surveyor under the laws of the State of Iowa.

Charles T. Vance — 19 May 2007
Charles T. Vance, PE & PLS — Date

License No. 5041

My License renewal date is 31, December 2007

List Corners to be Indexed

Corners	Section	Twp	Range
N.¼ Cor.	30	76	27
SW. Cor. NE.¼ SW.¼	30	76	27