

IND ✓
ANN
SCAN
CHK

LISA SMITH, COUNTY RECORDER
MADISON IOWA

Prepared By: J. Brian Morrissey, Morrissey Surveying, 1405 Hwy. G28, Otley, Ia. 50214, Tel. (641) 627-5554

UNITED STATES PUBLIC LAND SURVEY CORNER CERTIFICATE OF



Land Survey Monuments situated in Section 31, Township 74, Range 28, of the Fifth Principal Meridian, Madison County, Iowa.
Previously recorded in N.A. in County Recorders Office.
(book, page, document number, etc.)

(Show reason for preparing this certificate, the evidence and detailed procedures used in establishing the corner positions and monumentation found or placed.)

Monument Description and Remarks: Set 5/8" x 18" orange plastic capped rebar #7995 at center of NE 1/4. Position based on traversing all of Section, using fence evidence to establish position of Center of Section, County Highway plans, and found monuments to establish position of N 1/4 corner. NE 1/4 established using position of Center, N 1/4 Cor., and found monuments at NE Cor. and E 1/4 Cor..

PLAN VIEW

(Show a minimum of three reference ties to durable physical objects, relevant monuments and physical conditions that will enable recovery of the corner.)

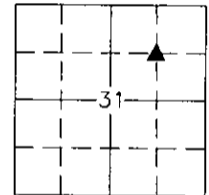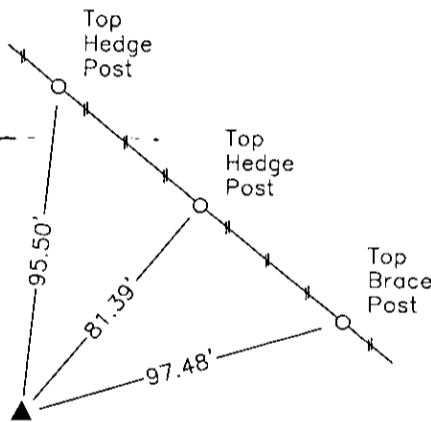

Set 5/8" x 18" Orange Plastic Capped Rebar #7995

SW COR NE NE SEC 31

NOTE: ALL TIES TO "X" NAILS UNLESS NOTED.



I hereby certify that the survey work was completed and this certificate was prepared by me or under my direct personal supervision and that I am a duly Licensed Land Surveyor under the laws of the State of Iowa.

Signature: J. Brian Morrissey Date: 6/4/07
J. Brian Morrissey

License number 7995.
My license renewal date is December 31, 2007