Document 2007 2773

Book 2007 Page 2773 Type 06 043 Pages 1
Date 7/12/2007 Time 1:38 PM
Rec Amt $7.00

INDX ✓
ANNO
SCAN

LISA SMITH. COUNTY RECORDER
MADISON IOWA

CHEK

RETURN TO: BOLDMAN LAND SURVEYING, P.C., BOX 66, WINTERSET, IA 50273 515-462-9242

# UNITED STATES PUBLIC LAND SURVEY CORNER CERTIFICATE

OF


Land Survey Monuments situated in Section 14 Township 75N, Range 29W, of the Fifth Principal Meridian, Madison County, Iowa
Previously recorded in None found In County Recorder's Office.
(book, page, document number, etc.)


(show reason for preparing this certificate, the evidence and detailed procedures used in establishing the corner positions and monumentation found or placed.)

Monument Description and Remarks: Looked for stone none found
Set 1/2" pin and cap by corner post.
All tied to PK nail and orange washer (NEW) unless noted otherwise

PLAN-VIEW

(Show a minimum of three reference ties to durable physical objects, relevant monuments and physical conditions that will enable recovery of the corner.)

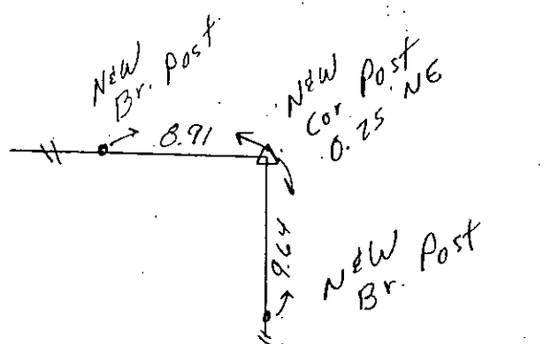

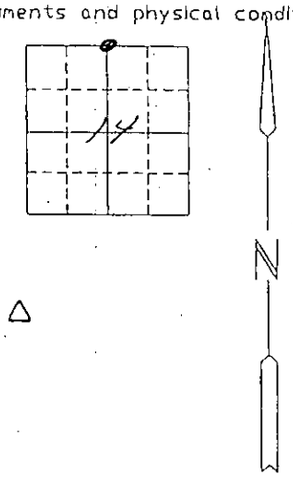
N¼ Cor - Set 1/2" pin and cap 0.25' NE. of corner post

I hereby certify that the survey work was completed and this certificate was prepared by me or under my direct personal supervision and that I am a duly Licensed Land Surveyor under the laws of the State of Iowa

Signature: Craig S. Boldman

Craig S. Boldman

Date: 6/25/07 Reg. No. 13427

SEAL

LICENSED LAND SURVEYOR
CRAIG S. BOLDMAN
13427
12/31/08
IOWA

List Corners to be Indexed

| Corners | Section | Twp | Range |
|---|---|---|---|
| N¼ | 14 | 75 | 29 |

Job # 07037