


LISA SMITH, COUNTY RECORDER
MADISON IOWA

CHEK


VANCE & HOCHSTETLER, P.C. CONSULTING ENGINEERS, WINTERSET, IOWA (515)462-3995
CHARLES T. VANCE, 110 WEST GREEN ST., WINTERSET, IOWA 50273-1533
JAMES M. HOCHSTETLER, 110 WEST GREEN ST., WINTERSET, IOWA 50273-1533

PLAT OF SURVEY OF LOT 4, BLOCK 2, T.D. JONES ADDITION TO CITY OF WINTERSET, MADISON COUNTY, IOWA OWNED BY DAVID BLAIR.

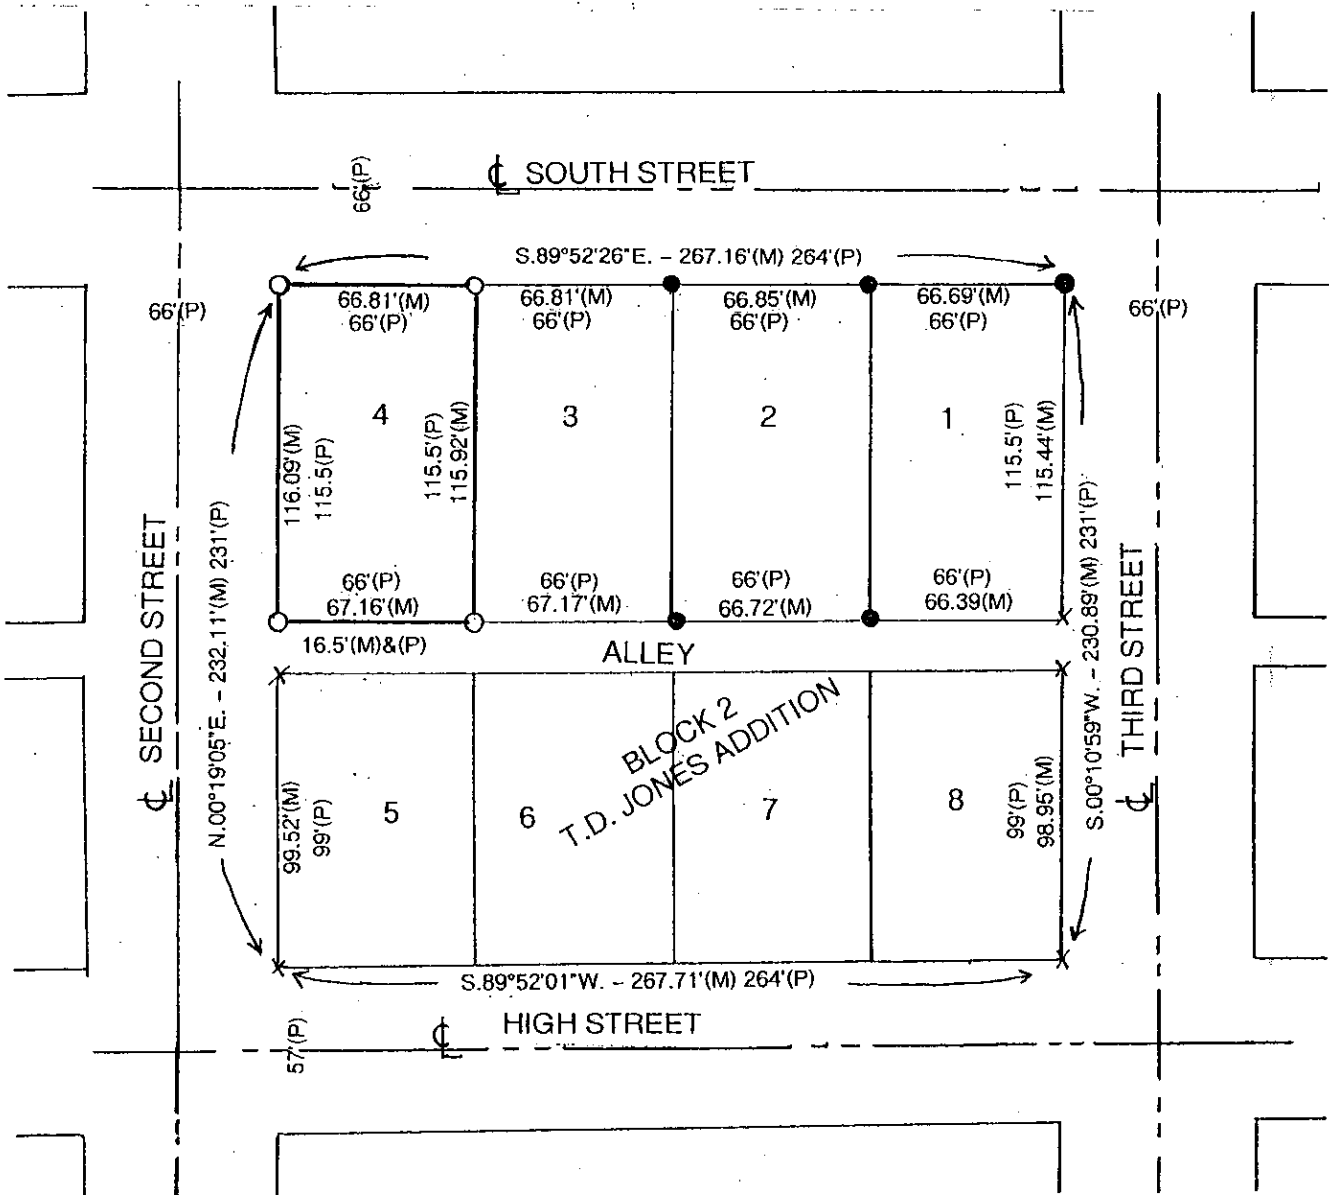

LEGAL DESCRIPTION:

Lot 4, Block 2, T.D. Jones Addition to the City of Winterset,
Madison County, Iowa.

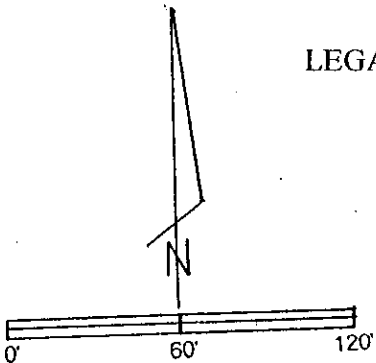

- SCALE 1" = 60'
- DATE OF SURVEY = 7/30/07
- CAPPED IRON ROD (CIR) #6808 SET
- 1/2" IRON ROD FOUND
- (M) MEASURED DISTANCE
- (P) PLATTED DISTANCE
- X CALCULATED POINT (NOTHING SET)

LICENSED LAND SURVEYOR

J. M. HOCHSTETLER #6808

IOWA

I hereby certify that this land surveying document was prepared and the related survey work was performed by me or under my direct personal supervision and that I am a duly licensed Land Surveyor under the laws of the State of Iowa.

J.M. Hochstetler
J.M. HOCHSTETLER
License number 6808 Date 8/7/07
My license renewal date is December 31, 2007
Pages or sheets covered by this seal: 1