

INDX ✓
ANNO
SCAN
CHEK

LISA SMITH, COUNTY RECORDER
MADISON IOWA


✓ VANCE & HOCHSTETLER, P.C. CONSULTING ENGINEERS, WINTERSET, IOWA (515) 462-3995

CHARLES T. VANCE, 110 WEST GREEN ST., WINTERSET, IOWA 50273-1533
JAMES M HOCHSTETLER, 110 WEST GREEN ST., WINTERSET, IOWA 50273 - 1533

07-1265

PROPERTY LINE RETRACEMENT SURVEY IN BLOCK
FOUR (4) OF KIRKWOOD'S ADDITION TO THE TOWN
OF WINTERSET, MADISON COUNTY, IOWA.

OWNED BY: LEWIS H. AND IRMA K. JORDAN.

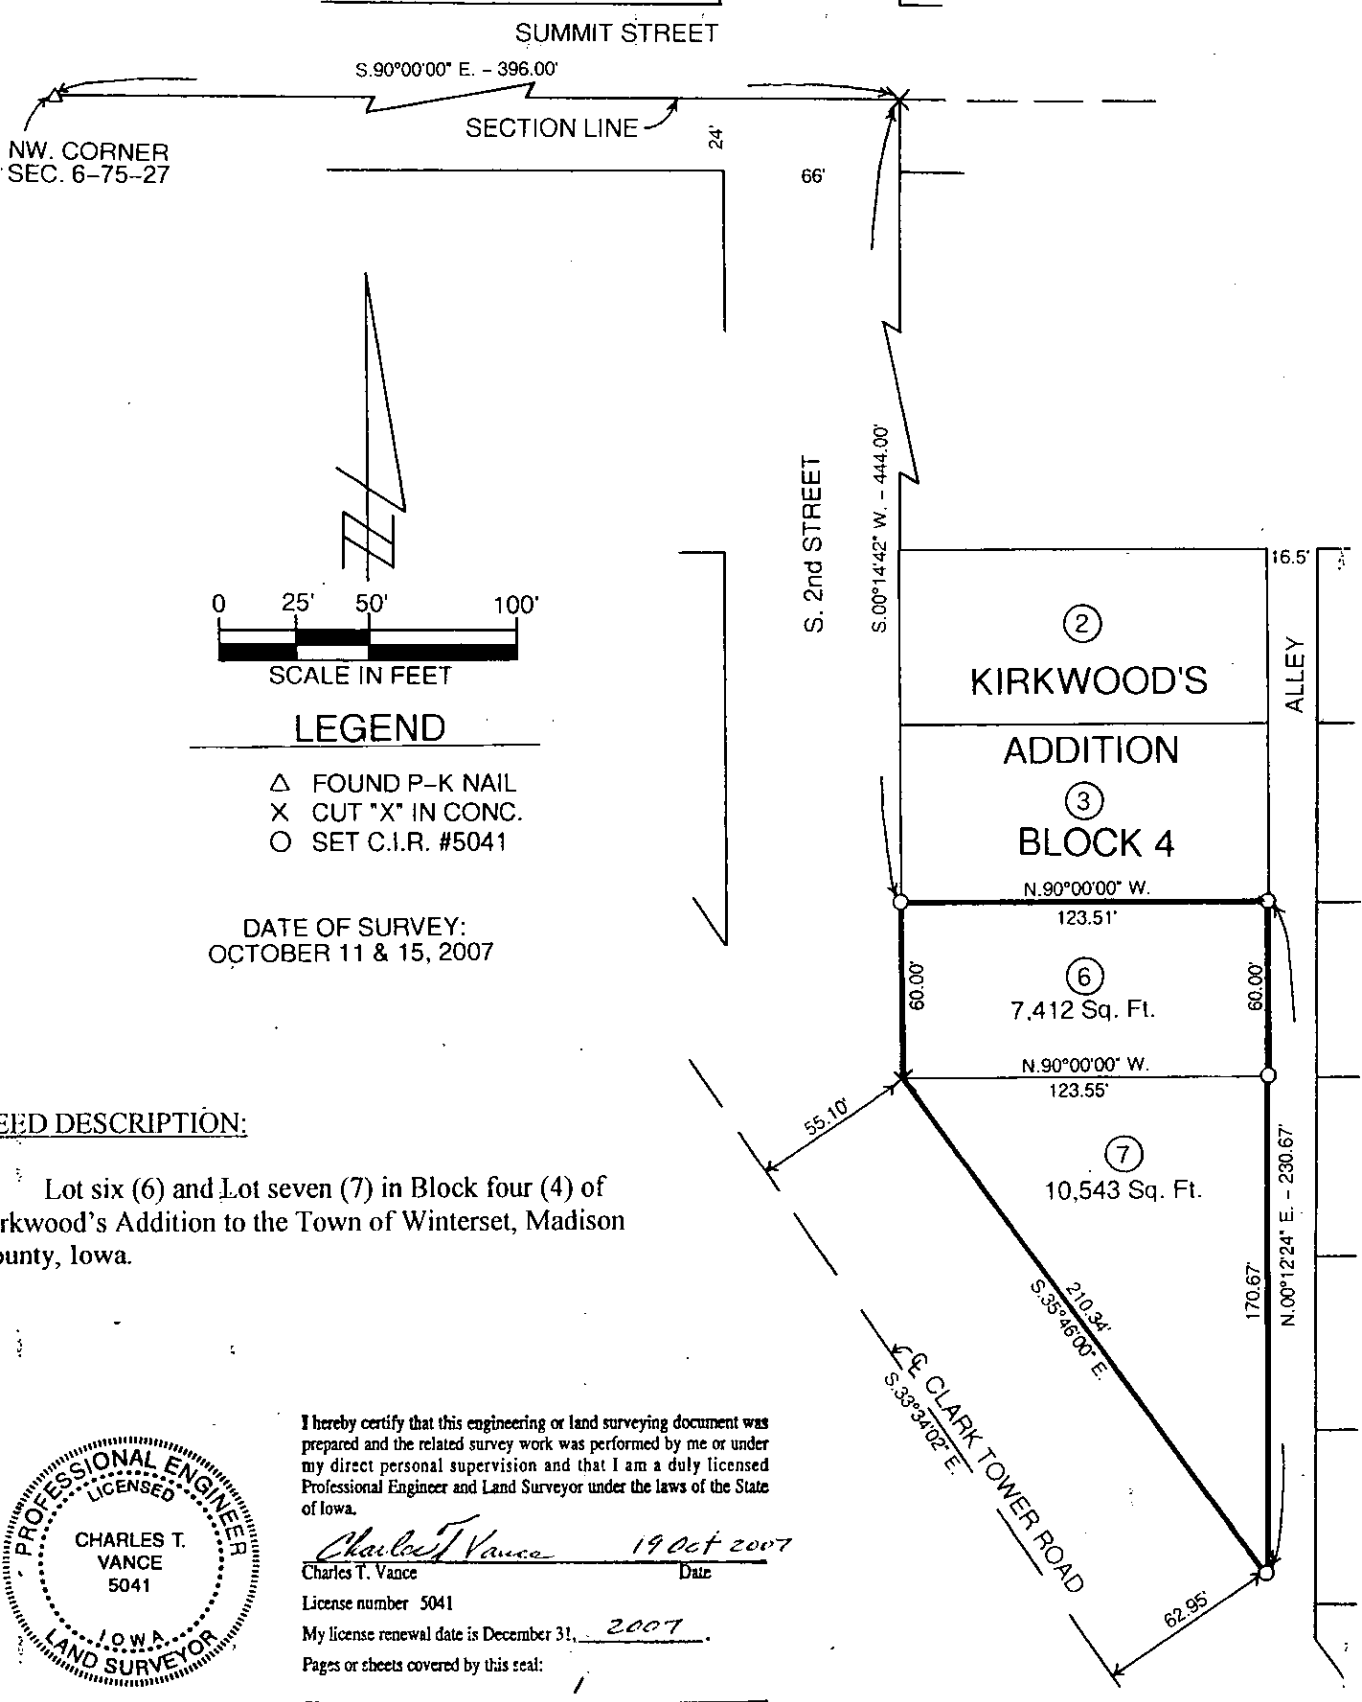

DEED DESCRIPTION:

Lot six (6) and Lot seven (7) in Block four (4) of
Kirkwood's Addition to the Town of Winterset, Madison
County, Iowa.

I hereby certify that this engineering or land surveying document was prepared and the related survey work was performed by me or under my direct personal supervision and that I am a duly licensed Professional Engineer and Land Surveyor under the laws of the State of Iowa.

Charles T. Vance 19 Oct 2007
Charles T. Vance Date
License number 5041
My license renewal date is December 31, 2007.
Pages or sheets covered by this seal: 1

