Document 2007 3360

Book 2007 Page 3360 Type 06 043 Pages 1
Date 8/30/2007 Time 3:54 PM
Rec Amt $7.00

INDX ✓
ANNO
SCAN

LISA SMITH, COUNTY RECORDER
MADISON IOWA

CHEK

VANCE & HOCHSTETLER, P.C., CONSULTING ENGINEERS, WINTERSET, IOWA (515) 462-3995
CHARLES T. VANCE, 110 West Green St., Winterset, Iowa, 50273
JAMES M HOCHSTETLER, 110 West Green St., Winterset, Iowa 50273

UNITED STATES PUBLIC LAND SURVEY CORNER CERTIFICATE

OF

Land Survey Monuments situated in Section 16, Township 75 N, Range 28 W, of the Fifth Principal Meridian, MADISON County, Iowa.
Previously recorded in _____ in County Recorder's Office.
(book, page, document number, etc.)

(Show reason for preparing this certificate, the evidence and detailed procedures used in establishing the the corner positions and monumentation found or placed.)


Monument Description and Remarks: W¼ COR. - Found ½" Iron Rod at approximate P.I. of County Road


SE COR. NW¼ SW¼ - Found ½" Iron Rod used as Corner for previous Survey in area.

NE Cor. NW¼ SW¼ - Found CIR" 5041 set for a Survey in the SW¼ NW¼.


PLAN - VIEW


(Show a minimum of three reference ties to durable physical objects, relevant monuments and physical conditions that will enable recovery of the corner.)

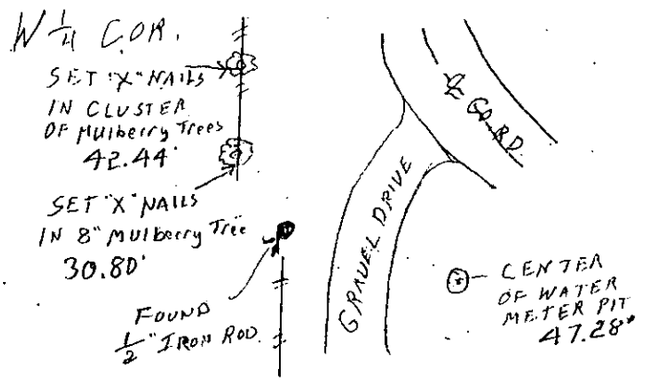

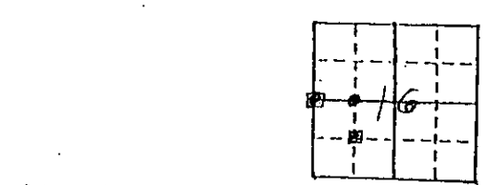

NE COR NW¼ SW¼.

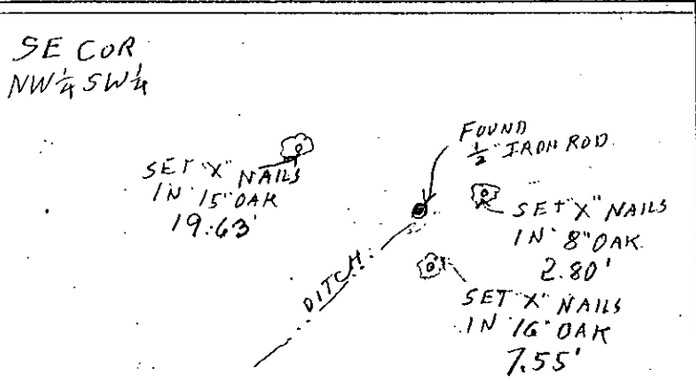

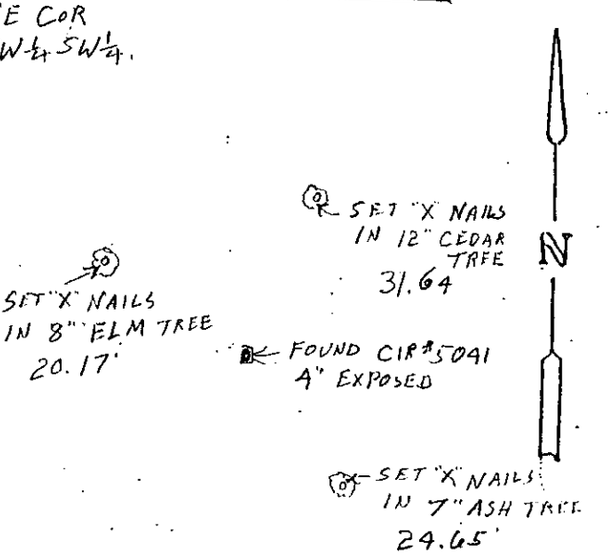

LICENSED LAND SURVEYOR
J. M. HOCHSTETLER
#6808
IOWA

I hereby certify that this land surveying document was prepared and the related survey work was performed by me or under my direct personal supervision and that I am a duly licensed Land Surveyor under the laws of the State of Iowa.

Jm Hochstetler
J.M. HOCHSTETLER
License number 6808 Date 8/30/07
My license renewal date is December 31, 2007
Pages or sheets covered by this seal: 1

List Corners to be Indexed

Corners	Section	Twp	Range
W¼ COR	16	75N	28W
SE COR NW¼ SW¼	16	75N	28W
NE COR NW¼ SW¼	16	75N	28W