Document 2007 4506

Book 2007 Page 4506 Type 06 043 Pages 1
Date 12/21/2007 Time 3:13 PM
Rec Amt $7.00

INDX ✓
ANNO ✓
SCAN
CHEK

LISA SMITH. COUNTY RECORDER
MADISON IOWA

Prepared by: Boldman Surveying Consultants, 521 West Green St. Winterset, Ia. 50273 Ph 515-462-9242

UNITED STATES PUBLIC LAND SURVEY CORNER CERTIFICATE

OF


Land Survey Monuments situated in Section 32, Township 76, Range 26, of the Fifth Principal Meridian, Madison County, Iowa
Previously recorded in Bk 2004 Pg 3593 In County Recorder's Office.
(book, page, document number, etc.)

(show reason for preparing this certificate, the evidence and detailed procedures used in establishing the corner positions and monumentation found or placed.)

Monument Description and Remarks: ① NW Cor. NE¼ SW¼. Fnd LS #5041 4.6' North of corner. Not accepted and removed. ② SW Cor NW¼ SW¼ not found reset using recorded monuments. ③ As shown All tied to pk nails [redacted]

PLAN-VIEW

(Show a minimum of three reference ties to durable physical objects, relevant monuments and physical conditions that will enable recovery of the corner.)

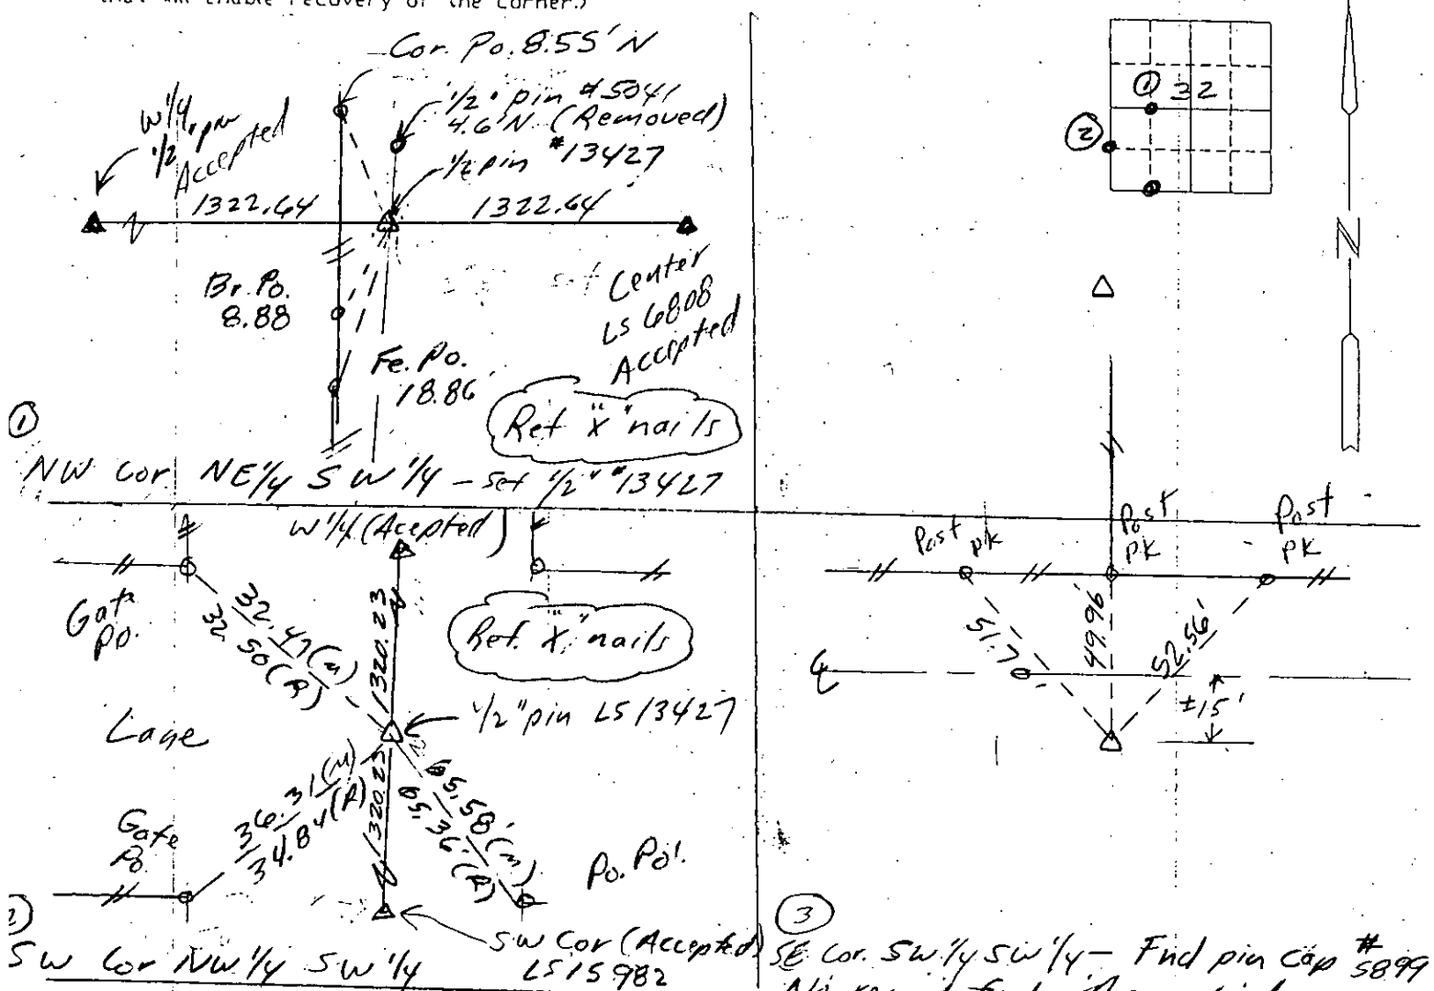

I hereby certify that the survey work was completed and this certificate was prepared by me or under my direct personal supervision and that I am a duly Licensed Land Surveyor under the laws of the State of Iowa

Signature: Craig S. Boldman

Date: 12/2/07 Reg. No. 13427

SEAL

LICENSED LAND SURVEYOR
CRAIG S. BOLDMAN
13427
12/31/08
IOWA

List Corners to be Indexed

Corners	Section	Twp	Range
NW NE¼ SW¼	32	76	26
SW NW¼ SW¼	32	76	26
SE SW¼ SW¼	32	76	26

Job # 07080