Document 2007 4507

Book 2007 Page 4507 Type 06 043 Pages 1
Date 12/21/2007 Time 3:13 PM
Rec Amt $7.00

INDX ✓
ANNO
SCAN

LISA SMITH, COUNTY RECORDER
MADISON IOWA

CHEK

Prepared by: Boldman Surveying Consultants, 521 West Green St. Winterset, Ia. 50273 Ph 515-462-9242

UNITED STATES PUBLIC LAND SURVEY CORNER CERTIFICATE

OF

Land Survey Monuments situated in Section 12, Township 74, Range 26, of the Fifth Principal Meridian, Madison County, Iowa
Previously recorded in None In County Recorder's Office.
(book, page, document number, etc.)


(show reason for preparing this certificate, the evidence and detailed procedures used in establishing the corner positions and monumentation found or placed.)


Monument Description and Remarks: As shown

All tied to pk nail [redacted] unless noted otherwise


PLAN-VIEW

(Show a minimum of three reference ties to durable physical objects, relevant monuments and physical conditions that will enable recovery of the corner.)

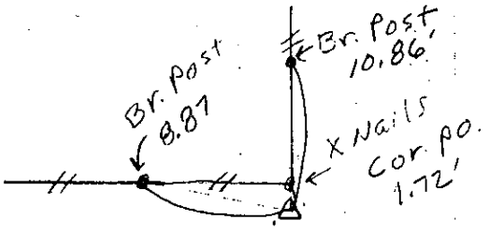


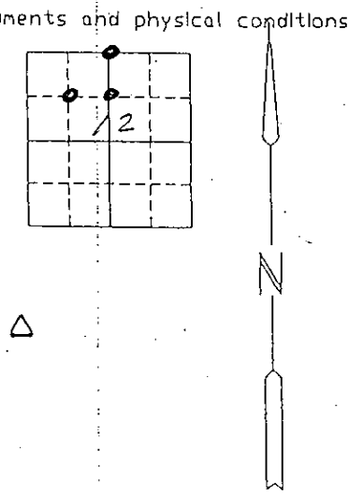

Center NW 1/4 – Fnd pin & cap 13427

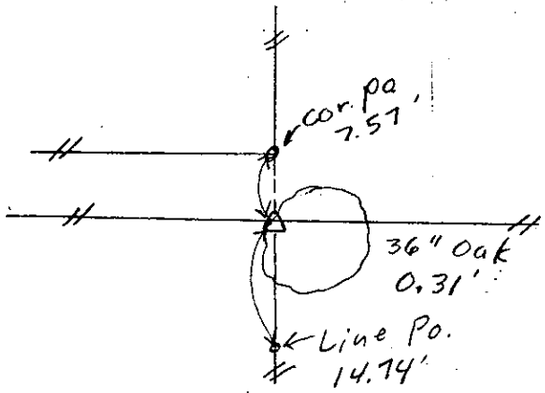

N 1/4 Cor. – Fnd 60d spike replaced w/ 1/2 pin & orange cap #13427

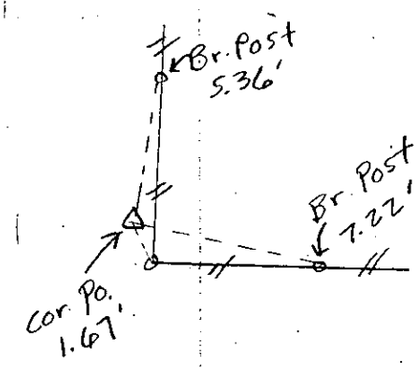

E 1/4 NW 1/4 – Set 1/2" pin & orange cap at midpoint E. line NW 1/4

I hereby certify that the survey work was completed and this certificate was prepared by me or under my direct personal supervision and that I am a duly Licensed Land Surveyor under the laws of the State of Iowa

Signature: Craig S. Boldman

Craig S. Boldman

Date: 12/21/07 Reg. No. 13427

SEAL

LICENSED LAND SURVEYOR
CRAIG S. BOLDMAN
13427
12/31/08
IOWA

List Corners to be Indexed

Corners	Section	Twp	Range
Center NW 1/4	12	74	26
N 1/4	12	74	26
E 1/4 NW 1/4	12	74	26

Job # 07081