Document 2007 4157

Book 2007 Page 4157 Type 06 043 Pages 1
Date 11/14/2007 Time 11:06 AM
Rec Amt $7.00

INDX ✓
ANNO
SCAN

LISA SMITH. COUNTY RECORDER
MADISON IOWA

CHEK

VANCE & HOCHSTETLER, P.C., CONSULTING ENGINEERS, WINTERSET, IOWA (515) 462-3995
CHARLES T. VANCE, 110 West Green St., Winterset, Iowa, 50273
JAMES M HOCHSTETLER, 110 West Green St., Winterset, Iowa 50273

05-425

UNITED STATES PUBLIC LAND SURVEY CORNER CERTIFICATE

OF

Land Survey Monuments situated in Section 17, Township 77 N, Range 26 W, of the Fifth Principal Meridian, MADISON County, Iowa.
Previously recorded in _____ in County Recorder's Office.
(book, page, document number, etc.)

(Show reason for preparing this certificate, the evidence and detailed procedures used in establishing the the corner positions and monumentation found or placed.)


Monument Description and Remarks: W¼ COR - Set yellow CIR #6808 at old corner post in property line fence North and on projected old property line fences South and East.


SW Cor NW¼ SW¼ - Set yellow CIR #6808 on line at midpoint between found CIR2592 at SW Cor. and set CIR #6808 at W¼ Cor.


SE Cor. NE¼ SW¼ - Set yellow CIR #6808 at midpoint on line between found Center and S¼ Cors.


PLAN - VIEW

(Show a minimum of three reference ties to durable physical objects, relevant monuments and physical conditions that will enable recovery of the corner.)

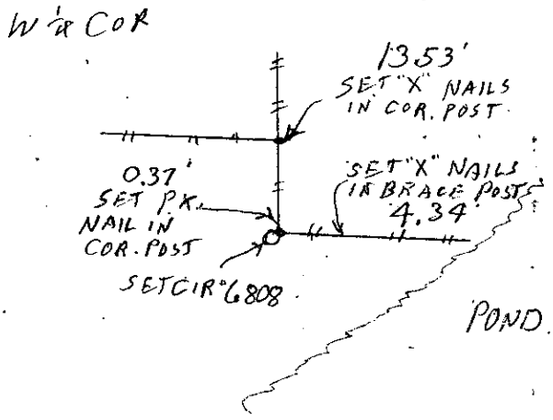

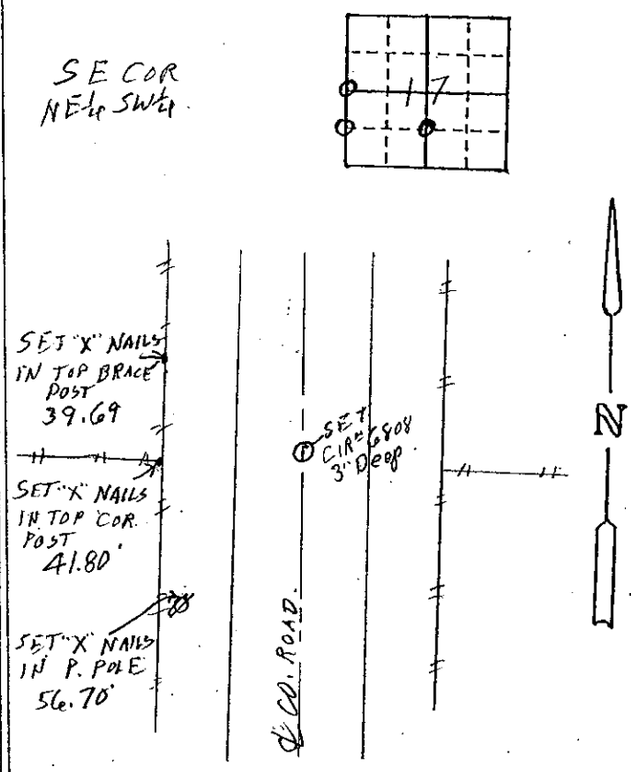

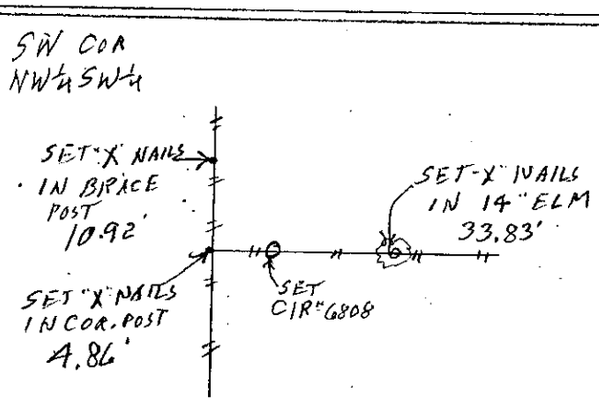

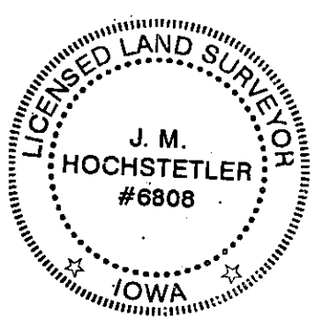

I hereby certify that this land surveying document was prepared and the related survey work was performed by me or under my direct personal supervision and that I am a duly licensed Land Surveyor under the laws of the State of Iowa.

J.M. HOCHSTETLER

License number 6808 Date 11/12/07

My license renewal date is December 31, 2007

Pages or sheets covered by this seal: 1

List Corners to be Indexed

Corners	Section	Twp	Range
W ¼ COR	17	77N	26W
SW COR NW¼ SW¼	17	77N	26W
S.E. COR NE¼ SW¼	17	77N	26W