

ument 2009 3562

2009 Page 3 11/24/2009 Amt \$7.00 3562 Type 06 026 Date Time 1:41 PM Rec Amt

5.60

S.89°28'55" E. 1,312.84

N.01°02'23" E. 260.46

EAST BANK OF NORTH RIVER

NORTHEAST QUARTER THAT IS NORTH & WEST OF THE SOUTH & AMENDED TO ADD THAT PART OF SOUTHEAST QUARTER OF THE

N.00°06'02" W 347.39

AMENDS A PLAT FÎLED ON 11-19-09 ÎN BOOK 2009 PAGE 3524. PLAT

QUARTER AND THE SOUTH HALF OF THE NORTHEAST QUARTER ALL IN SECTION 13, TOWNSHIP 76 NORTH, RANGE 29 WEST OF THE 5TH P.M., MADISON COUNTY, IOWA OWNED BY LONNA J. NIELSEN. PLAT OF SURVEY IN THE SOUTHEAST QUARTER OF THE NORTHWEST

NW COR. SW 1/4 NE.1/4

INDX **ANNO SCAN** CHEK

VANCE & HOCHSTETLER, P.C. • CONSULTING ENGINEERS • WINTERSET. IOWA • 50273

CHARLES T. VANCE • 110 WEST GREEN ST., WINTERSET, IOWA • (515) 462-3995 ES M HOCHSTETLER • 110 WEST GREEN ST., WINTERSET, IOWA • FAX: (515) 462 9845

€CLASS B_ RQAD

N.00°11'30"

974.60

GROSS AREA = 25.11 AC. CO.RD. ROW = 0.02 AC. NET AREA = 25.09 AC.

N.42°44'03" W. 82.33"

SE.1/4 NW.1/4

GROSS AREA = 53.50 AC. CO.RD. ROW = 0.02 AC. NET AREA = 53.48 AC.

PARCEL "H"


SW COR

S.89°45'50" W. - 1,311.21"

911.72

473.84 S.00°59'22" E.

CENTER IN CULTIVATED FIELD

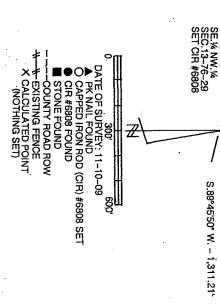

LEGAL DESCRIPTION:

County, Iowa more particularly described as follows: Northeast Quarter all in Section 13, Township 76 North, Range 29 West of the 5th P.M., Madison Parcel "H" in the Southeast Quarter of the Northwest Quarter and the South Half of the

said Section 13; thence North 89°37'04" East 1,312.55 feet to the Point of Beginning containing of the Northeast Quarter; thence South 88°26'04" West 1,319.74 feet to a point on the West line of said Southwest Quarter of the Northeast Quarter; thence North 42°44'03" West 82.33 feet; Section 13, Township 76 North, Range 29 West of the 5th P.M., Madison County, Iowa thence 53.50 acres including 0.02 acres of County Road right-of-way. West 347.39 feet to the Northwest Corner of the Southwest Quarter of the Northeast Quarter of three-fourths (3/4) of said Southeast Quarter of the Northwest Quarter; thence North 00°06′02″ Northwest Quarter; thence South 89°28'55" East 1,312.84 feet along the North line of the Soutl thence North 00°11'30" West 974.60 feet along the West line of said Southeast Quarter of the West 911.72 feet to the Southwest Corner of said Southeast Quarter of the Northwest Quarter; ine of Southeast Quarter of the Northwest Quarter of said Section 13; thence South 89°45'50" thence South 88°52'32" West 351.14 feet; thence South 00°59'22" East 473.84 feet to the South Quarter; thence South 00°33'07" East 423.22 feet along the East line of said Southwest Quarter 54°14'35" West 233.76 feet to a point on the East line Southwest Quarter of the Northeast North 89°31'33" East 424.98 feet; thence South 37°22'03" West 380.73 feet; thence South Beginning at the Northeast Corner of the Southwest Quarter of the Northeast Quarter of

> HOCHSTETLER #6808

> > hereby certify that this

ages or sheets

covered by this seal:

(24/

