
COMPUTER RECORDED COMPARED

137 FILED NO ...

BOOK\_3\_\_PAGE\_51\_\_

97 JUL 10 PM 4: 20

RECORDER
MADISON COUNTY, IOWA

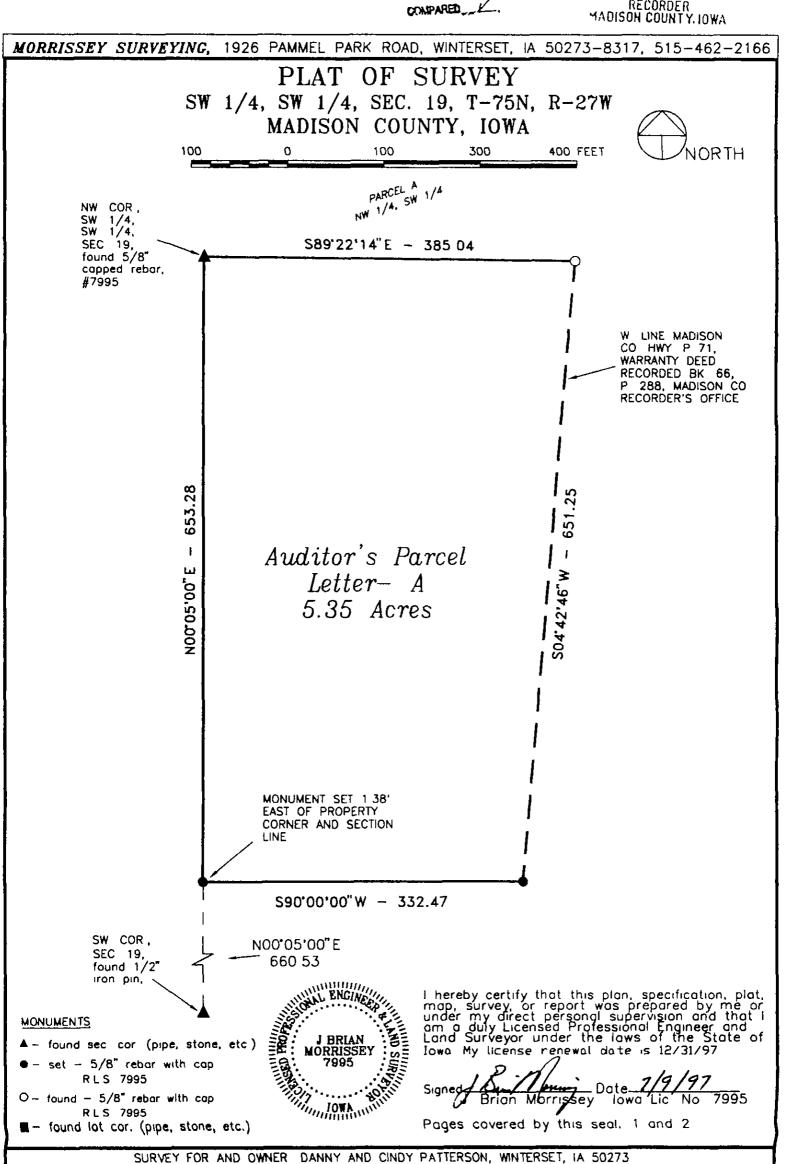

DATE OF SURVEY 6/28/97

PROJ NO 134-96B

51

MORRISSEY SURVEYING, 1926 PAMMEL PARK ROAD, WINTERSET, IA 50273-8317, 515-462-2166

## PLAT OF SURVEY SW 1/4, SW 1/4, SEC. 19, T-75N, R-27W MADISON COUNTY, IOWA

## DESCRIPTION - PARCEL A

That part of the Southwest Quarter of the Southwest Quarter of Section 19, Township 75 North, Range 27 West of the Fifth Principal Meridian, Madison County, Iowa, described as follows

Beginning at the northwest corner of the Southwest Quarter of the Southwest Quarter of said Section 19;

thence on an assumed bearing of South 89 degrees 22 minutes 14 seconds East 385 04 feet to the west line of Madison County Highway P 71,

thence South 04 degrees 42 minutes 46 seconds West along said west line a distance of 651 25 feet;

thence South 90 degrees 00 minutes 00 seconds West 332 47 feet to the west line of the Southwest Quarter of said Section 19;

thence North 00 degrees 05 minutes 00 seconds East along the west line of said Southwest Quarter of the Southwest Quarter a distance of 653.28 feet to the northwest corner of the Southwest Quarter of the Southwest Quarter of said Section 19 and the point of beginning

Said tract contains 5.35 acres

SURVEY FOR AND OWNER DANNY AND CINDY PATTERSON, WINTERSET, IA 50273

PROJ. NO. 134-96B

DATE OF SURVEY 6/28/97

PAGE 2