

FILED NO. 3368 BOOK 3 PAGE 11

1800 : 10 00

97 HAY 30 PH 3: 26

RM. \$1.00

MICHELLE UTSLER RECORDER MADISON COUNTY. 10%

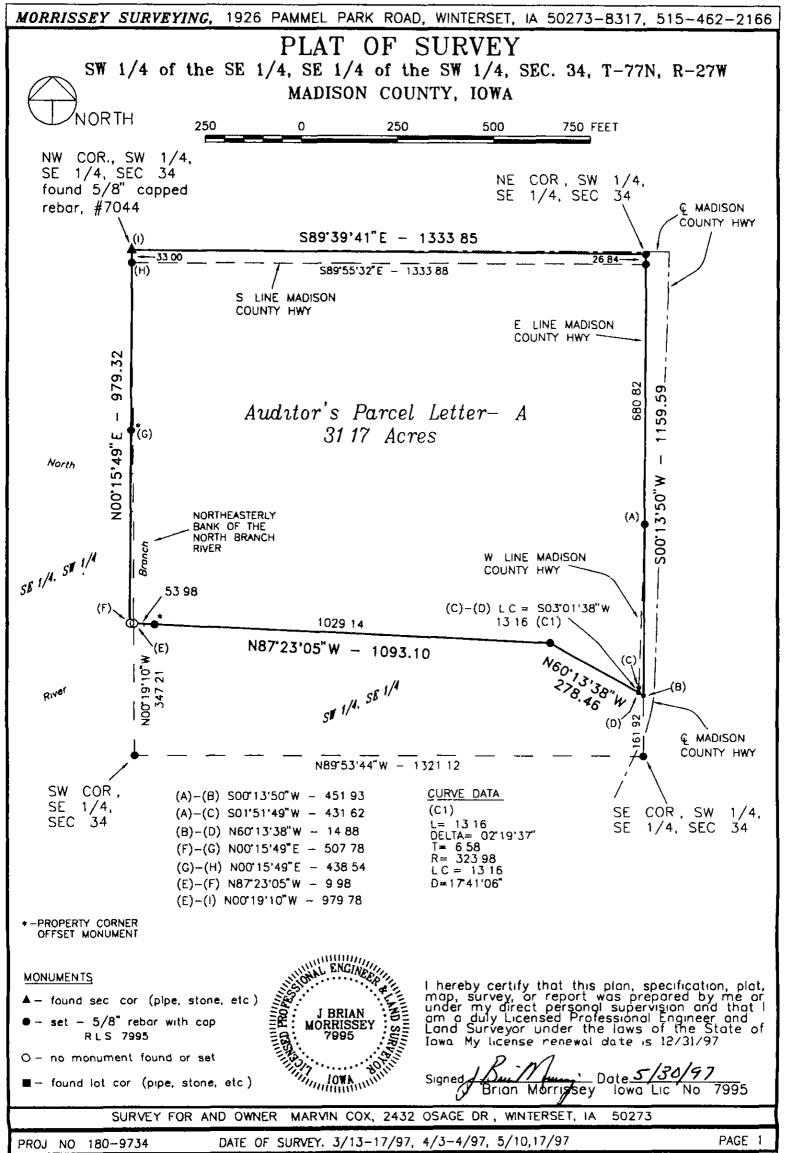

FARM PLAT 3

MORRISSEY SURVEYING, 1926 PAMMEL PARK ROAD, WINTERSET, IA 50273-8317, 515-462-2166

## PLAT OF SURVEY

SW 1/4 of the SE 1/4, SE 1/4 of the SW 1/4, SEC. 34, T-77N, R-27W MADISON COUNTY, IOWA

## DESCRIPTION - PARCEL A

That part of the Southwest Quarter of the Southeast Quarter and the Southeast Quarter of the Southwest Quarter of Section 34, Township 77 North, Range 27 West of the Fifth Principal Meridian, Madison County, Iowa, described as follows

Beginning at the northwest corner of the Southwest Quarter of the Southeast Quarter of said Section 34,

thence on an assumed bearing of South 89 degrees 39 minutes 41 seconds East along the north line of the Southwest Quarter of the Southeast Quarter of said Section 34 a distance of 1333 85 feet.

thence South 00 degrees 13 minutes 50 seconds West along the east line of said Southwest Quarter of the Southeast Quarter a distance of 1159 59 feet,

thence North 60 degrees 13 minutes 38 seconds West 278.46 feet,

thence North 87 degrees 23 minutes 05 seconds West 1093 10 feet,

thence North 00 degrees 15 minutes 49 seconds East 979 32 feet to the northwest corner of the Southwest Quarter of the Southeast Quarter of soid Section 34 and the point of beginning.

Said tract contains 31 17 acres and is subject to Madison County Highway Easement over the northerly and southeasterly 0.99 acres thereof

AREA BY 1/4, 1/4 SECTION

SE 1/4, SW 1/4 = 0.11 ACRES (ROW = LESS THAN 0.01 ACRES) SW 1/4, SE 1/4 = 31.06 ACRES (ROW = 0.99 ACRES)



I hereby certify that this plan, specification, plat, map, survey, or report was prepared by me or under my direct personal supervision and that I am a duly Licensed Professional Engineer and Land Surveyor under the laws of the State of Iowa My license renewal date is 12/31/97

Signed Brian Marrissey Date 5/30/97
Brian Marrissey lowa Lic No 7995

SURVEY FOR AND OWNER MARVIN COX, 2432 OSAGE DR, WINTERSET, IA 50273

PROJ NO 180-9734

DATE OF SURVEY 3/13-17/97, 4/3-4/97, 5/10,17/97

PAGE 2