

IOWA STATE BAR ASSOCIATION  
Official Form No. 104

# 1,898,789 -

FOR THE LEGAL EFFECT OF THE USE  
OF THIS FORM, CONSULT YOUR LAWYER

REAL ESTATE TRANSFER	
TAX PAID 42	
STAMP #	
\$2087.25	
Mary E. Welty	
RECODER	
9-30-88	Madison
DATE	COUNTY

COMPUTER

COMPUTERIZED

FILED NO. 700  
BOOK 54 PAGE 520

1988 SEP 30 PM 4:22

MARY E. WELTY  
RECODER  
MADISON COUNTY, IOWA  
IND. ✓  
REC. ✓  
PAGE ✓

Fee \$15.00  
Transfer \$5.00

SPACE ABOVE THIS LINE  
FOR RECORDER



WARRANTY DEED  
(CORPORATE GRANTOR)

For the consideration of Ten  
Dollar(s) and other valuable consideration, BETHESDA FOUNDATION, a non-profit corporation,  
a corporation organized and existing under the laws of Nebraska,  
does hereby Convey to MTC WEST, INC., a Delaware corporation, located at One PPG Place, Suite 2260,  
Pittsburgh, Pennsylvania 15222


the following described real estate in Madison County, Iowa:

The East 459.65 feet of the Southwest Quarter of the Southeast Quarter  
of the Southwest Quarter, except the North 25 feet of the east 25 feet  
thereof, and except the South 165 feet of the East 132 feet thereof, of  
Section 36, Township 76 North, Range 28 West of the 5th P.M., Madison  
County, Iowa.

subject to easements, reservations, and restrictions of record, and further subject to the interests  
disclosed in a survey dated 9/29/88, 1988, a copy of which is attached hereto.  
as revised 9/23/88.

The Corporation hereby covenants with grantees, and successors in interest, that it holds the real estate by title in fee  
simple; that it has good and lawful authority to sell and convey the real estate; that the real estate is free and clear of all liens  
and encumbrances, except as may be above stated; and it covenants to Warrant and Defend the real estate against the  
lawful claims of all persons, except as may be above stated.


Words and phrases herein, including acknowledgment hereof, shall be construed as in the singular or plural number;  
according to the context.

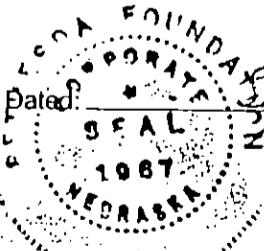

BETHESDA FOUNDATION, a Nebraska non-profit corporation

By David Burdine  
DAVID BURDINE, President Title  
By R. Stewart Walker  
ASSISTANT SECRETARY Title

STATE OF Nebraska COUNTY, ss:  
On this 28th day of September, 1988 before me, the undersigned, a Notary  
Public in and for said State, personally appeared DAVID BURDINE and R. Thomas  
Walker to me personally known, who being by me duly sworn, did say that they are the President  
and Assistant Secretary, respectively, of said corporation; that notary public is properly acknowledged corporation; that said instrument was signed  
(the seal affixed thereto is the seal of said)  
and sealed on behalf of said corporation by authority of its Board of Directors; and that the said President  
and Secretary as such officers, acknowledged the execution of said  
instrument to be the voluntary act and deed of said corporation, by it and by them voluntarily executed.

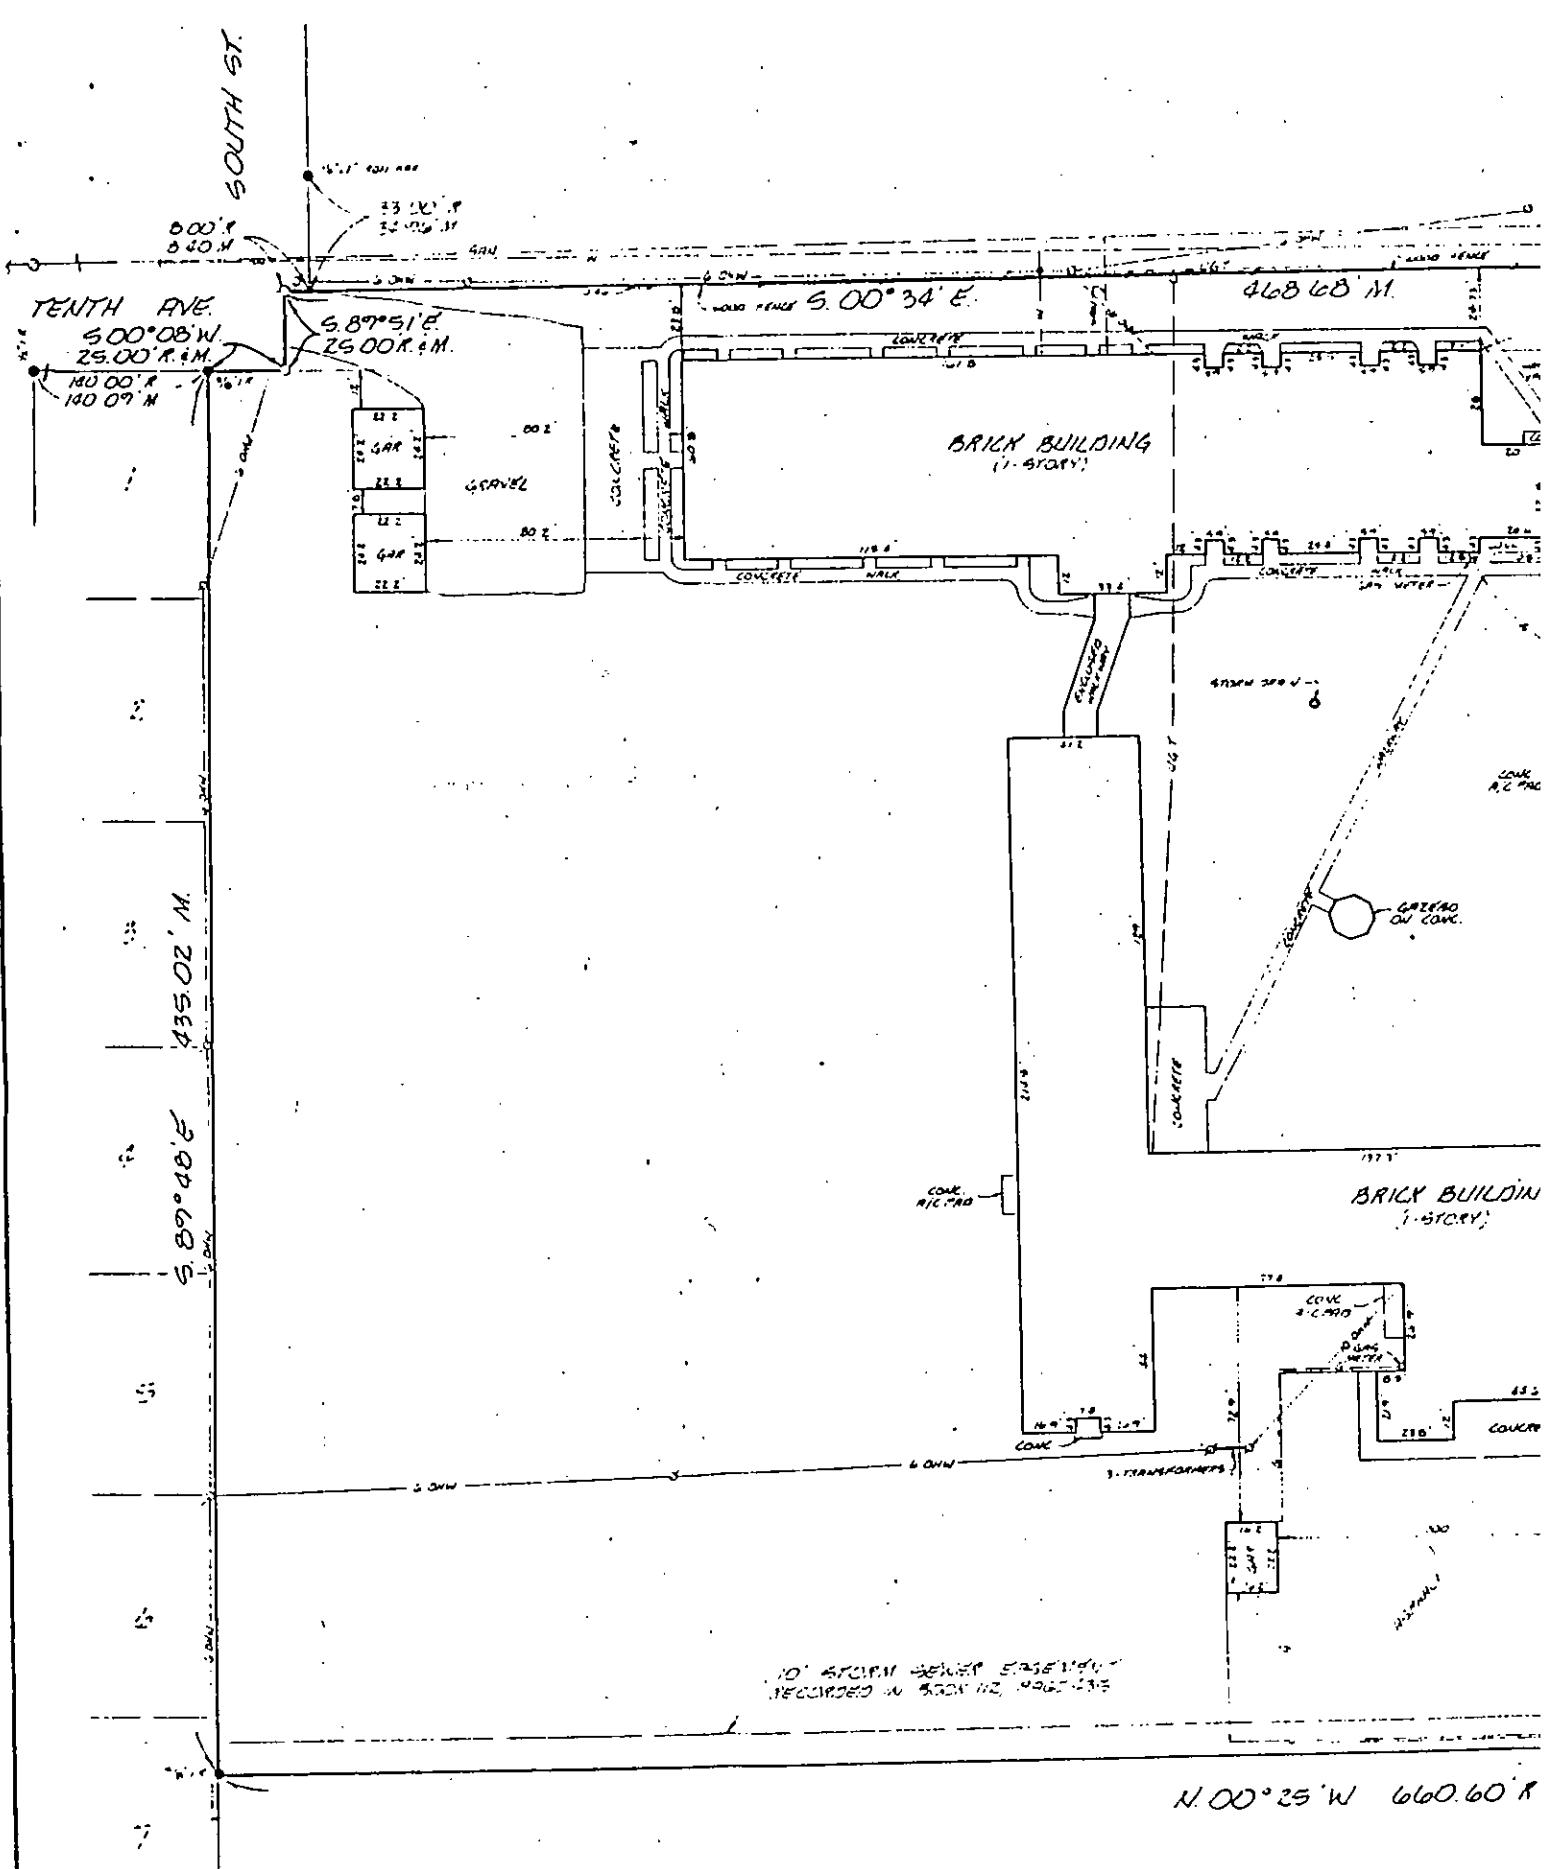

Mark	Description	Date	By


CERTIFICATION  
 I hereby certify that this Plan and Survey was made by me or under my direct personal supervision, and that it is a duly registered Land Surveyor under the laws of the state of Iowa.  
 RICHARD A. GEIGERSON  
 9105  
 4-27-86

NOTE THE EASEMENT RECORDED  
 PAGE 535 DOES NOT FEESE SHOWN AND DESCRIBED HERE

ALTA SURVEY

4600 FT 1000 FT 1000 FT  

4 1/2 CORNER  
460 No. 16-23  
460 CUT IN CORNER

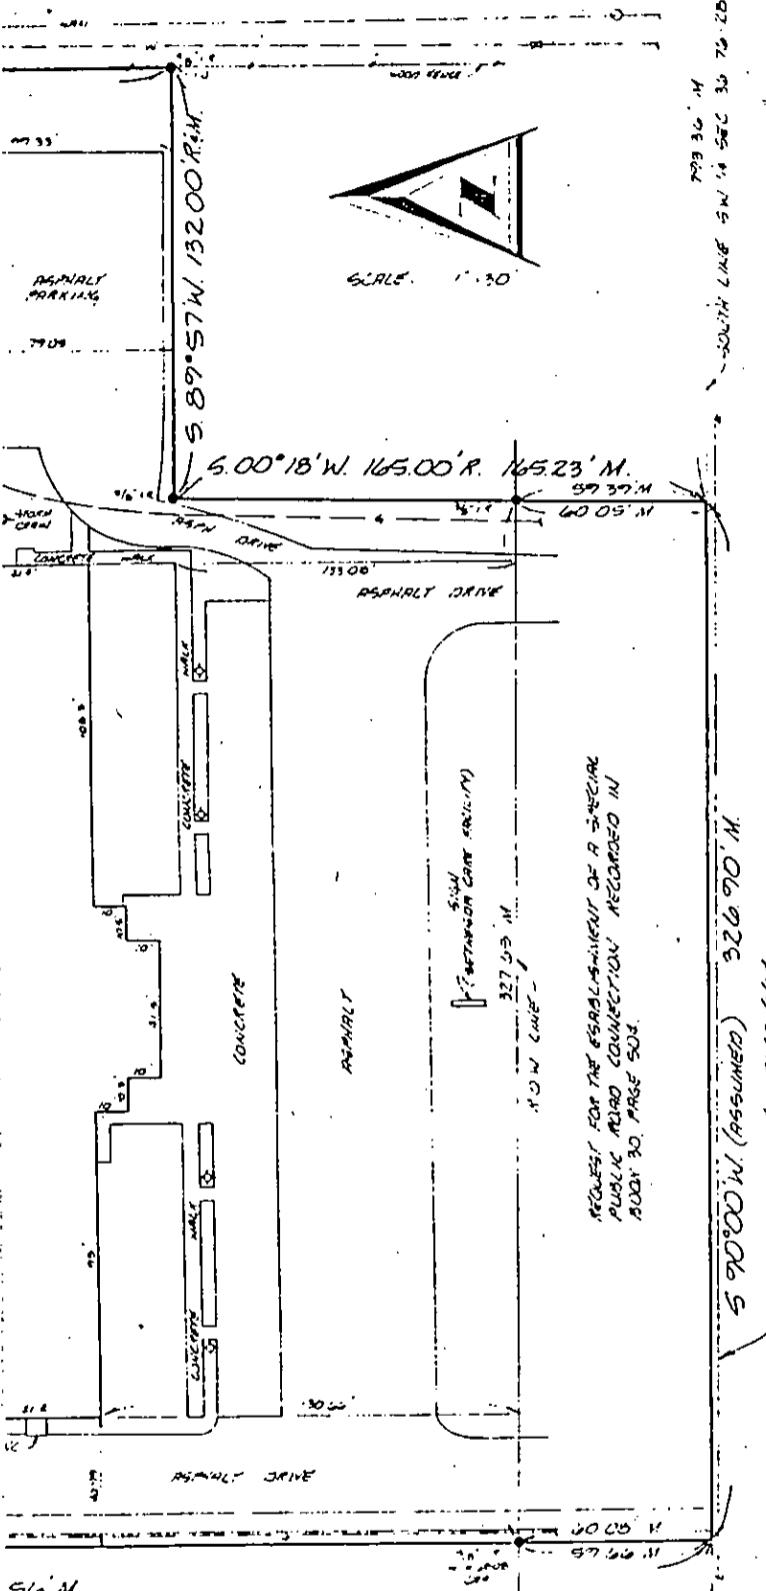

LEGAL DESCRIPTION:


SURVEY CERTIFICATE

**10:** AND TO: First American Title Insurance Company  
HIC West, Inc. and Security Land Title Company  
210 Monette, Inc. 1905 Barney Street, Toledo  
One PPG Place, Suite 2200 Grand, MI  
Pittsburgh, PA 15222

**ADD TO:** Fidelity Bank, National Association, as agent for itself and other banks named in the credit and agency agreement dated as of September 30, 1983.

Survey entered: "ALTA survey for Security Land Title Company", dated April 26, 1965, prepared by Anderson Consultants, Inc.

The undersigned hereby certifies to the addressee hereof that this survey was prepared from an actual on-the-ground instrument survey of the subject premises performed under my responsible direction and supervision and is correct to the best of my knowledge and belief; that the same was made in accordance with the "Minimum Standard Detail Requirements for Land Title Surveys" jointly established and adopted by ALTA and AGSM in 1982; that the same accurately shows the location of the boundaries of the subject premises and the location of all streets, highways, alleys and public ways crossing or abutting said premises; that the dimensions of the improvements and the location thereof with respect to the boundaries are accurately shown as the same were situated on April 25, 1988, that there are no encroachments by improvements appurtenant to adjoining premises upon the subject premises, nor from the subject premises upon adjoining property unless shown herein, that all easements and rights of way which are appurtenant to or burden the subject premises, and (ii) are referred to in the Title Commitment dated September 15, 1988, or (iii) are apparent from a visual inspection, are delineated herein, and that no part of the subject premises is located at or below the base flood elevation designated by Federal Emergency Management Agency under the National Flood Insurance Program, or within any similar state or municipal flood hazard area or districts unless specifically shown herein.

The undersigned further certifies that access to and ingress from the subject premises and the improvements and structures thereon to a public way are provided via the means indicated herein; and municipal water, municipal storm sewer and municipal sanitary sewer facilities and telephone, gas and electric services of public utilities are available in the locations indicated herein.


**WITNESS/ATTEST:**


Stephen J. Shels

Richard D. Odenbach

**ANDERSONS CONSULTANTS, INC.**

Kerry Richard R. Odenbach



### Surveyor's Notes:

1. Maximum positional tolerance of the property corners exceeds 1 foot in 10 thousand feet.
  2. Measured bearings and distances must be used to compute horizontal closure.
  3. The location of underground utilities such as sanitary and storm sewers, gas, telephone, electric or water lines on or adjacent to the property shown, and described hereon is unknown except where shown.

**LEGEND**

•	Found 1/2" or 5/8" Iron Rod
O	Set 1/2" Iron Rod w/BLT #7105 Cap
e	Recorded Distance
M	Measured Distance
— — — 400 — — —	Sanitary Sewer
— — — W — — —	Water Main
— — — G — — —	Gas Main
— — — 061 — — —	Underground Telephone
②	Manhole
oo	Gate Valve
•	Curb Stop
#	Power Pole
→	Light Pole
6 ONW	Overhead Wire S No.

R SECURITY LAND TITLE COMPANY

anderson consultants  
1440 Ingersoll avenue  
des moines, iowa 50309  
engineering • planning • survey

ph. (515)288-4923