Document 2010 297

Book 2010 Page 297 Type 06 043 Pages 1
Date 2/11/2010 Time 2:55 PM
Rec Amt $9.00

INDX ✓
ANNO
SCAN
CHEK

LISA SMITH, COUNTY RECORDER
MADISON COUNTY IOWA

VANCE & HOCHSTETLER, P.C., CONSULTING ENGINEERS, WINTERSET, IOWA (515) 462-3995
CHARLES T. VANCE, 110 West Green St., Winterset, Iowa, 50273
JAMES M HOCHSTETLER, 110 West Green St., Winterset, Iowa 50273

10-35


UNITED STATES PUBLIC LAND SURVEY CORNER CERTIFICATE OF

Land Survey Monuments situated in Section 11, Township 77-N, Range 27 W., of the Fifth Principal Meridian, MADISON County, Iowa.
Previously recorded in _____ in County Recorder's Office.
(book, page, document number, etc.)

(Show reason for preparing this certificate, the evidence and detailed procedures used in establishing the the corner positions and monumentation found or placed.)
Monument Description and Remarks: SE COR NE¼NW¼ - Found ½" Iron Rod 3" deep in ℄ County Road. Shown as set by Lynn Sickels on a plat of survey filed on Aug. 19, 1974 and recorded in Book 1, Page 105.
Center - Found ½" Iron Rod 4" deep in ℄ County Road. Shown on same plat as above.

PLAN - VIEW

(Show a minimum of three reference ties to durable physical objects, relevant monuments and physical conditions that will enable recovery of the corner.)

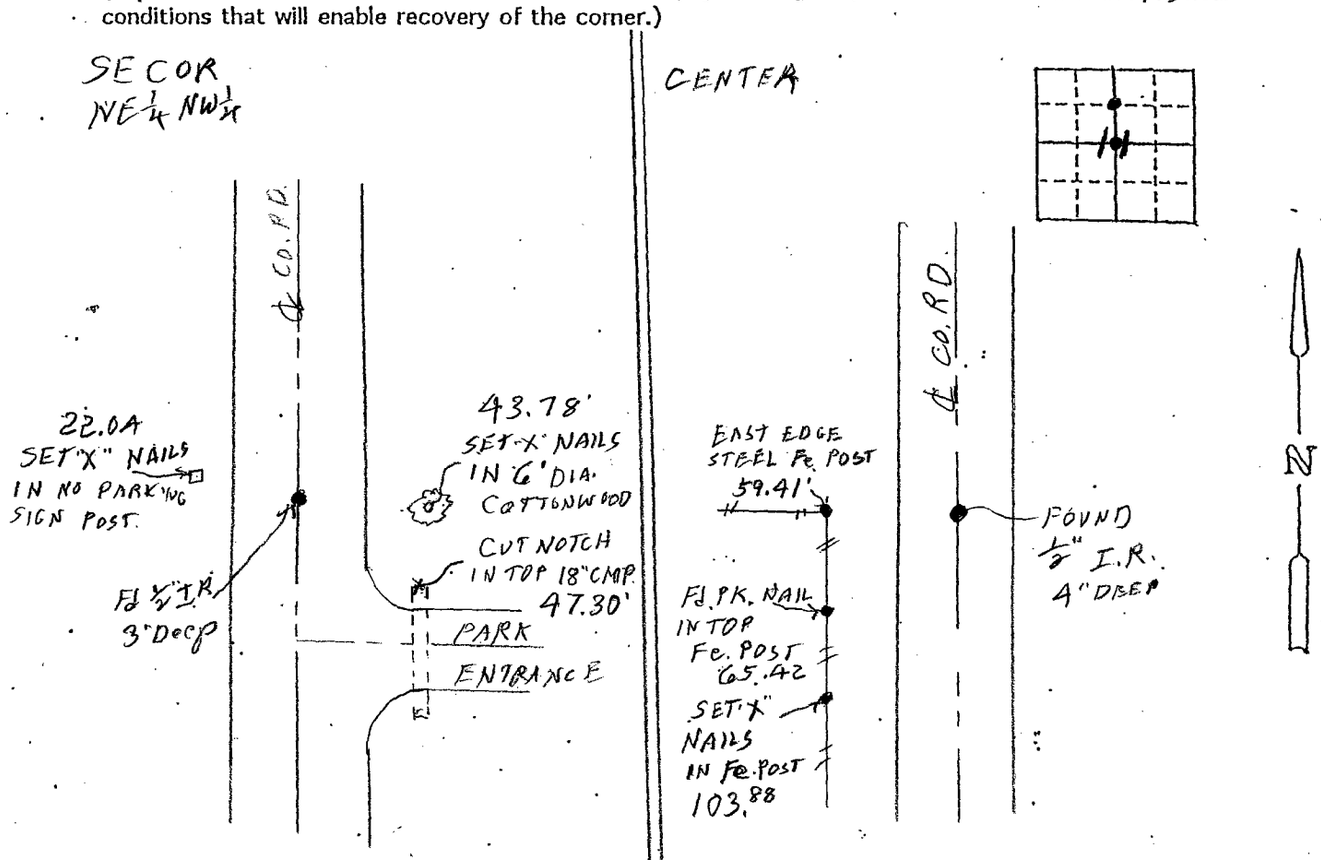

I hereby certify that this land surveying document was prepared and the related survey work was performed by me or under my direct personal supervision and that I am a duly licensed Land Surveyor under the laws of the State of Iowa.

J.M. HOCHSTETLER
License number 6808 Date 2/11/10
My license renewal date is December 31, 2011
Pages or sheets covered by this seal: 1

LICENSED LAND SURVEYOR J. M. HOCHSTETLER #6808 IOWA

List Corners to be Indexed

Corners	Section	Twp	Range
SE COR NE¼ NW¼	11	77N	27W
CENTER	11	77N	27W