Document 2010 438

Book 2010 Page 438 Type 06 043 Pages 1
Date 3/03/2010 Time 10:52 AM
Rec Amt $9.00

INDX
ANNO
SCAN

LISA SMITH. COUNTY RECORDER
MADISON COUNTY IOWA

CHEK

VANCE & HOCHSTETLER,P.C. CONSULTING ENGINEERS, WINTERSET, IOWA (515)462-3995

CHARLES T. VANCE, 110 WEST GREEN ST.,WINTERSET, IOWA 50273
JAMES M. HOCHSTETLER, 110 WEST GREEN ST., WINTERSET, IOWA 50273

UNITED STATES PUBLIC LAND SURVEY CORNER CERTIFICATE

OF


Land Survey Monuments situated in Section 22, Township 77 North, Range 26 West, of the Fifth Principal Meridian, Madison County, Iowa.
Previously recorded in N/A (book, page, document number, etc.) in County Recorder's Office.

(Show reason for preparing this certificate, the evidence and detailed procedures used in establishing the corner positions and monumentation found or placed.)

Monument Description and Remarks: Set capped iron rod No. 5041 on line between the Northeast Corner and the Southeast Corner of Section 22, T77N, R26W. of the 5th P.M. at mid distance between said Corners.

PLAN - VIEW

(Show a minimum of three reference ties to durable physical objects, relevant monuments and physical conditions that will enable recovery of the corner.)

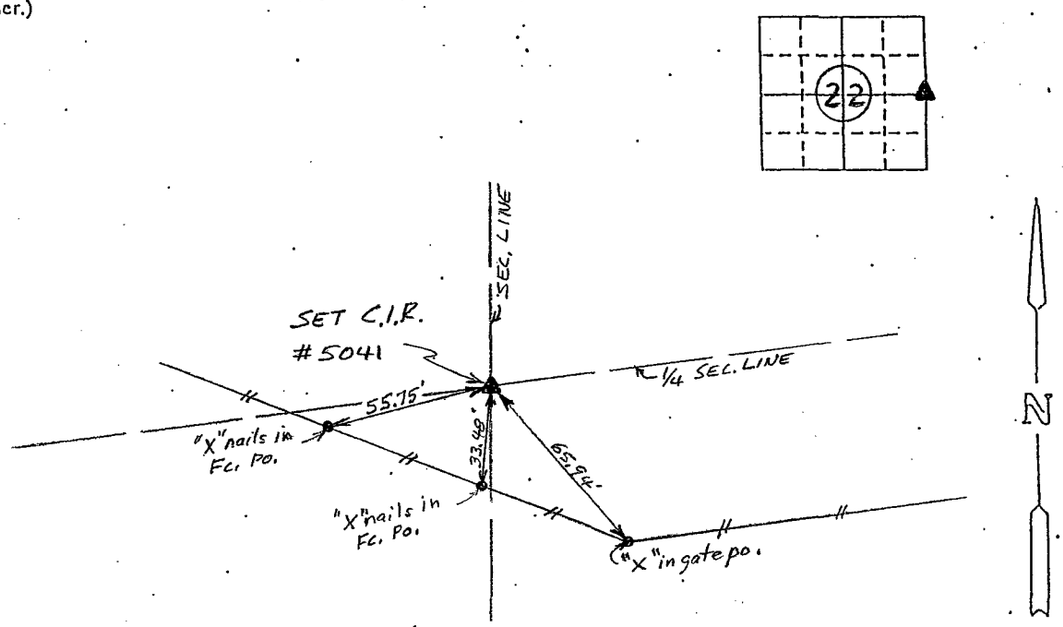

Ref. to E. 1/4 CORNER, SECTION 22, T.77N, R.26W.

I hereby certify that this land surveying document was prepared and the related survey work was preformed by me or under my direct personal supervision and that I am a duly Licensed Land Surveyor under the laws of the State of Iowa.

Charles T. Vance 1 Feb. 2010
Charles T. Vance, PE & PLS — Date

License No. 5041

My License renewal date is 31, December 2011

PROFESSIONAL ENGINEER LICENSED CHARLES T. VANCE 5041 IOWA LAND SURVEYOR

List Corners to be Indexed

Corners	Section	Twp	Range
E. 1/4 COR.	22	T. 77N.	R.26W.