

FILED NO. **637**



BOOK **3** PAGE **84**

97 AUG 12 PM 3:07

MICHELLE UTZ LLI
RECORDER
MADISON COUNTY, IOWA

VANCE & HOCHSTETLER, P.C. CONSULTING ENGINEERS, WINTERSSET, IOWA (515)462-3995

CHARLES T. VANCE, 110 WEST GREEN ST., WINTERSSET, IOWA 50273
JAMES M. HOCHSTETLER, 110 WEST GREEN ST., WINTERSSET, IOWA 50273

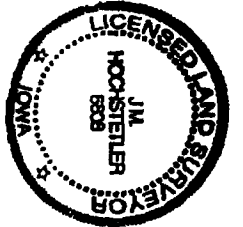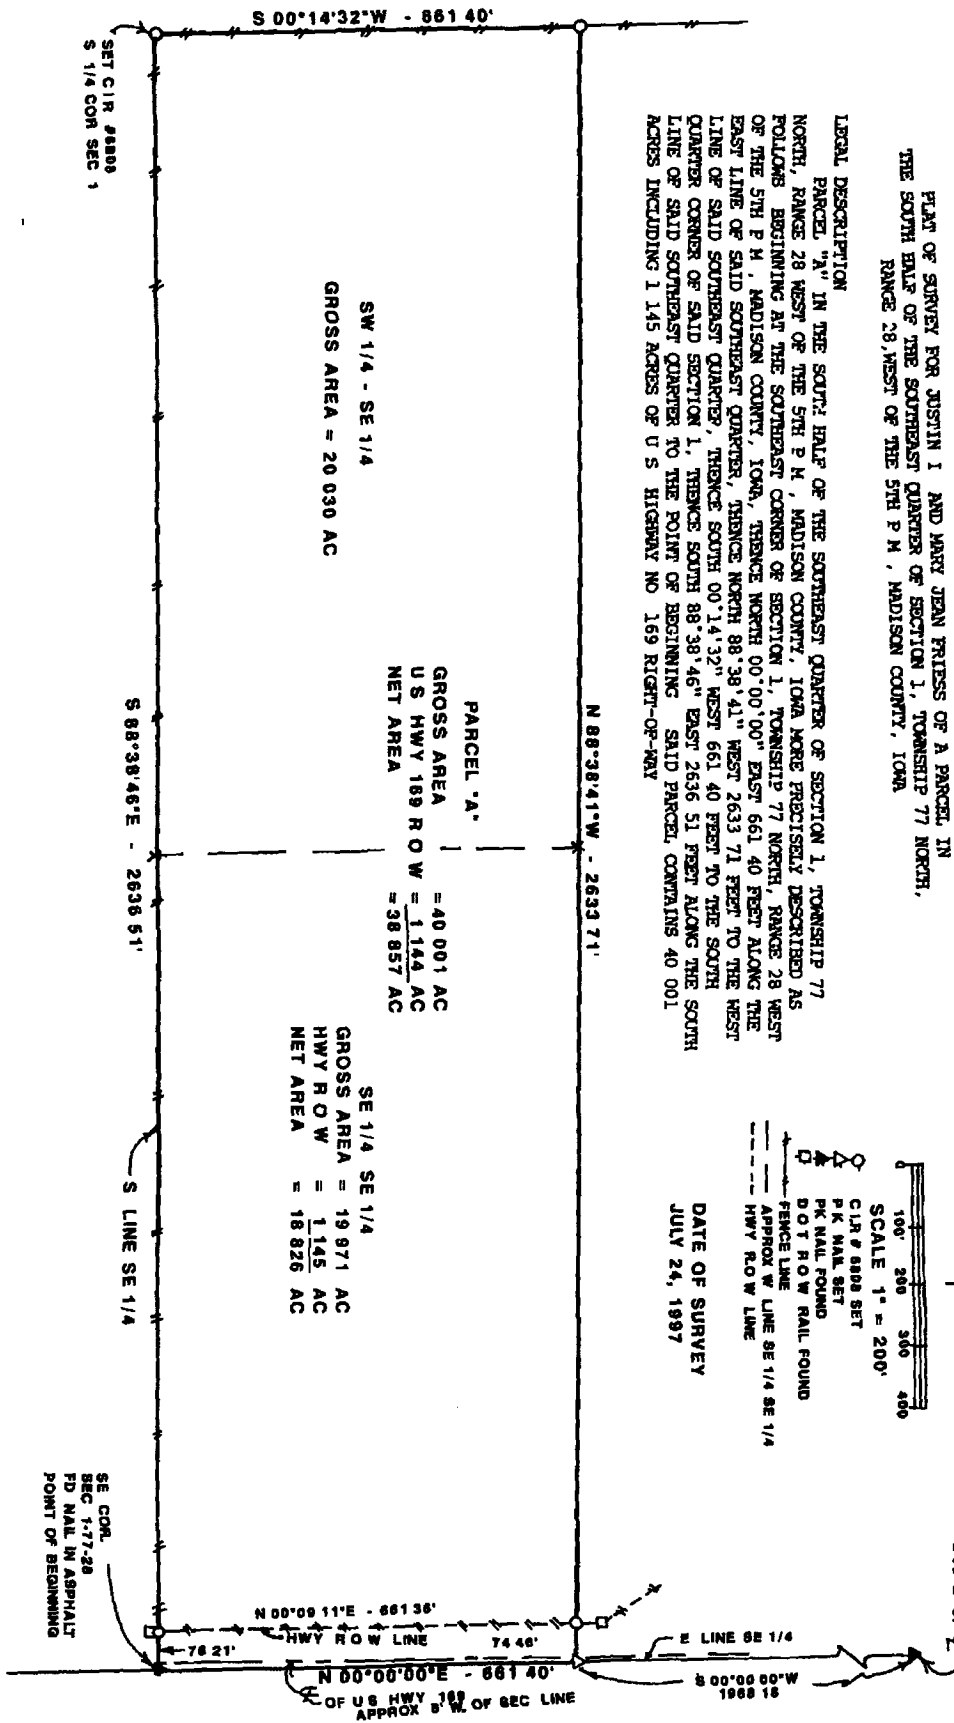

I hereby certify that this land surveying document was prepared and the same was prepared by me or under my direct supervision and that I am a duly Licensed Land Surveyor in the State of Iowa.

J. M. Hochstetler
 JAMES M. HOCHSTETLER
 My license expires the 1st day of July 1997
 Paper or record surveyed by this seal